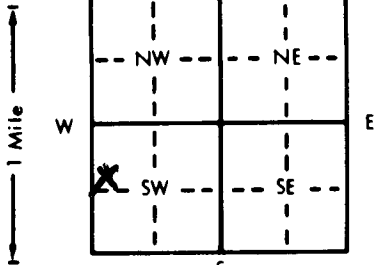


1 LOCATION OF WATER WELL: County: <u>Sedgwick</u> Fraction: <u>SW 1/4 NW 1/4 SW 1/4</u> Section Number: <u>24</u> Township Number: <u>T 27 S</u> Range Number: <u>R 2 E</u>
--

Distance and direction from nearest town or city street address of well if located within city?

See Below

2 WATER WELL OWNER: <u>LONNIE STOUT</u> RR#, St. Address, Box #: <u>247 Cardinal Lane</u> City, State, ZIP Code: <u>WICHITA KS 67235</u>	Board of Agriculture, Division of Water Resources Application Number:
--	--

3 LOCATE WELL'S LOCATION WITH AN "X" IN SECTION BOX: 	4 DEPTH OF COMPLETION WELL: <u>78</u> ft. ELEVATION: Depth(s) Groundwater Encountered 1. ft. 2. ft. 3. ft. WELL'S STATIC WATER LEVEL <u>22</u> ft. below land surface measured on mo/day/yr <u>5-31-94</u> Pump test data: Well water was ft. after hours pumping gpm Est. Yield gpm: Well water was ft. after hours pumping gpm Bore Hole Diameter in. to ft., and in. to ft. WELL WATER TO BE USED AS: 5 Public water supply 8 Air conditioning 11 Injection well 1 Domestic 3 Feedlot 6 Oil field water supply 9 Dewatering 12 Other (Specify below) 2 Irrigation 4 Industrial <u>7 Lawn and garden only</u> 10 Monitoring well Was a chemical/bacteriological sample submitted to Department? Yes No If yes, mo/day/yr sample was submitted Water Well Disinfected? Yes No
--	--

5 TYPE OF BLANK CASING USED: 1 Steel 3 RMP (SR) <u>2 PVC</u> 4 ABS Blank casing diameter in. to ft., Dia in. to ft., Dia in. to ft. Casing height above land surface in., weight lbs./ft. Wall thickness or gauge No. TYPE OF SCREEN OR PERFORATION MATERIAL: <u>UNKNOWN</u> 1 Steel 3 Stainless steel 5 Fiberglass 8 RMP (SR) 2 Brass 4 Galvanized steel 6 Concrete tile 9 ABS SCREEN OR PERFORATION OPENINGS ARE: 1 Continuous slot 3 Mill slot 5 Gauzed wrapped 8 Saw cut 11 None (open hole) 2 Louvered shutter 4 Key punched 6 Wire wrapped 9 Drilled holes 7 Torch cut 10 Other (specify) <u>NA</u> SCREEN-PERFORATED INTERVALS: From <u>NA</u> ft. to <u>NA</u> ft., From ft. to ft. GRAVEL PACK INTERVALS: From <u>UNKNOWN</u> ft. to ft., From ft. to ft.

6 GROUT MATERIAL: <u>22</u> 1 Neat cement 3 <u>2</u> Cement grout 3 Bentonite 4 Other Grout Intervals: From <u>22</u> ft. to <u>3</u> ft., From ft. to ft., From ft. to ft. What is the nearest source of possible contamination: 1 Septic tank 4 Lateral lines 7 Pit privy 10 Livestock pens 14 Abandoned water well 2 Sewer lines 5 Cess pool 8 Sewage lagoon 11 Fuel storage 15 Oil well/Gas well 3 Watertight sewer lines 6 Seepage pit 9 Feedyard 12 Fertilizer storage 16 Other (specify below) 13 Insecticide storage <u>NA</u> Direction from well? How many feet?

FROM	TO	LITHOLOGIC LOG	FROM	TO	PLUGGING INTERVALS
			<u>78</u>	<u>22</u>	<u>GRAVEL</u>
			<u>22</u>	<u>3</u>	<u>Cement</u>
					<u>well was plugged due to termite treatment and well was in garage</u>

7 CONTRACTOR'S OR LANDOWNER'S CERTIFICATION: This water well was (1) constructed, (2) reconstructed, or (3) plugged under my jurisdiction and was completed on (mo/day/year) <u>5-31-94</u> and this record is true to the best of my knowledge and belief. Kansas Water Well Contractor's License No. <u>718</u> This Water Well Record was completed on (mo/day/yr) <u>5-31-94</u> under the business name of <u>Wenger Dully</u> by (signature) <u>[Signature]</u>
