

1 LOCATION OF WATER WELL:		Fraction		Section Number		Township Number		Range Number	
County: SEDGWICK		SE 1/4	NE 1/4	SW 1/4	25	T 27	S	R 2 E	E/W


1 LOCATION OF WATER WELL:		Fraction		Section Number		Township Number		Range Number	
County: SEDGWICK		SE 1/4	NE 1/4	SW 1/4	25	T 27	S	R 2 E	E/W

Distance and direction from nearest town or city street address of well if located within city?

1261 S. Sagebrush Ct., Wichita, Ks.

2	WATER WELL OWNER: Custom Care	SPEC. HOUSE	
	RR#, St. Address, Box # : 2440 S. Sheridan		Board of Agriculture, Division of Water Resources
	City, State, ZIP Code : Wichita, Ks.		Application Number:

3 LOCATE WELL'S LOCATION WITH AN "X" IN SECTION BOX: 4 DEPTH OF COMPLETED WELL..... 80 ft. ELEVATION:

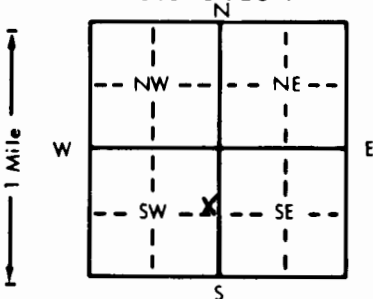

Depth(s) Groundwater Encountered 1. 15 ft. 2. _____ ft. 3. _____ ft.

WELL'S STATIC WATER LEVEL 15 ft. below land surface measured on mo/day/yr 5-27-82

Pump test data: Well water was _____ ft. after _____ hours pumping _____ gpm

Est. Yield _____ gpm: Well water was _____ ft. after _____ hours pumping _____ gpm

Bore Hole Diameter 1.1 in. to _____ ft., and _____ in. to _____ ft.

WELL WATER TO BE USED AS:

5 Public water supply	8 Air conditioning	11 Injection well
<u>1 Domestic</u>	3 Feedlot	6 Oil field water supply
2 Irrigation	4 Industrial	9 Dewatering
	7 Lawn and garden only	10 Observation well
		12 Other (Specify below)

Was a chemical/bacteriological sample submitted to Department? Yes.....No.....X....; If yes, mo/day/yr sample was submitted _____

Water Well Disinfected? Yes X No _____

5	TYPE OF BLANK CASING USED:		5 Wrought iron	8 Concrete tile	CASING JOINTS: Glued . . X . . Clamped Welded Threaded
	1 Steel	3 RMP (SR)	6 Asbestos-Cement	9 Other (specify below)	
	2 PVC	4 ABS	7 Fiberglass		

Blank casing diameter 5 . in. to . . . 20 . . . ft., Dia in. to ft. Dia in. to ft.
Casing height above land surface . . . 12 . in., weight . . . 1.59 . . . lbs./ft. Wall thickness or gauge No. . . . 203

TYPE OF SCREEN OR PERFORATION MATERIAL:			7 PVC	10 Asbestos-cement
1 Steel	3 Stainless steel	5 Fiberglass	<u>8 RMP (SR)</u>	11 Other (specify)
2 Brass	4 Galvanized steel	6 Concrete tile	9 ABS	12 None used (open hole)

SCREEN OR PERFORATION OPENINGS ARE:		5 Gauzed wrapped	8 Saw cut	11 None (open hole)
1 Continuous slot	3 Mill slot	6 Wire wrapped	9 Drilled holes	
2 Louvered shutter	4 Key punched	7 Torch cut	10 Other (specify)	

SCREEN-PERFORATED INTERVALS:	From 20 ft. to 80 ft.,	From ft. to ft.
	From ft. to ft.,	From ft. to ft.
GRAVEL PACK INTERVALS:	From 14 ft. to 80 ft.,	From ft. to ft.
	From ft. to ft.,	From ft. to ft.

6	GROUT MATERIAL:	1 Neat cement	2 Cement grout	3 Bentonite	4 Other
	Grout Intervals:	From 4 ft. to 14 ft.	From	ft. to	ft. From ft. to ft.

What is the nearest source of possible contamination:			10 Livestock pens	14 Abandoned water well
1 Septic tank	4 Lateral lines	7 Pit privy	11 Fuel storage	15 Oil well/Gas well
2 Sewer lines	5 Cess pool	8 Sewage lagoon	12 Fertilizer storage	16 Other (specify below)
3 Watertight sewer lines	6 Seepage pit	9 Feedyard	13 Insecticide storage	
Direction from well? Northwest			How many feet? 80	

[illegible]

7 CONTRACTOR'S OR LANDOWNER'S CERTIFICATION: This water well was (1) constructed, (2) reconstructed, or (3) plugged under my jurisdiction and was completed on (mo/day/year) 5-26-82 and this record is true to the best of my knowledge and belief. Kansas Water Well Contractor's License No. 236 This Water Well Record was completed on (mo/day/yr) 6-21-82 under the business name of Harp Well & Pump Serv., Inc. by (signature) M. Arnold

INSTRUCTIONS: Use typewriter or ball point pen, PLEASE PRESS FIRMLY and PRINT clearly. Please fill in blanks, underline or circle the correct answers. Send top three copies to Kansas Department of Health and Environment, Division of Environment, Environmental Geology Section, Topeka, KS 66620. Send one to WATER WELL OWNER and retain one for your records.