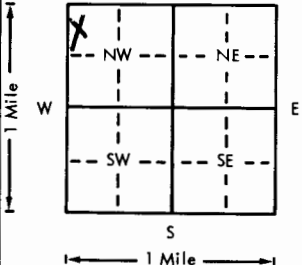


USE TYPEWRITER OR BALL
POINT PEN-PRESS FIRMLY,
PRINT CLEARLY.

WATER WELL RECORD
KSA 82a-1201-1215

Kansas Department of Health and
Environment-Division of Environment
(Water well Contractors)
Topeka, Kansas 66620

1. Location of well:		County Sedgwick	Fraction NW SW NW SW 1/4 NW 1/4 NW 1/4	Section number 25	Township number T 27 S	Range number R 2 E ///
2. Distance and direction from nearest town or city: Street address of well location if in city: 14401 Willow Bend Wichita, Kansas			3. Owner of well: Dr. Ron Barth R.R. or street: 14401 Willow Bend City, state, zip code: Wichita, Kansas			
4. Locate with "X" in section below: N 1 Mile W E S 1 Mile			Sketch map: 			
5. Type and color of material			From	To	6. Bore hole dia. 11 in. Completion date 8-17-76 Well depth 75 ft.	
Sandy Topsoil			0	3	7. ☒ Cable tool ☒ Rotary ☐ Driven ☐ Dug ☐ Hollow rod ☐ Jetted ☐ Bored ☐ Reverse rotary	
Clay			3	15	8. Use: ☐ Domestic ☐ Public supply ☐ Industry ☐ Irrigation ☐ Air conditioning ☐ Stock ☒ Lawn ☐ Oil field water ☐ Other	
Shale			15	75	9. Casing: Material styrene Height: Above or below /// Threaded ☐ Welded ☒ Surface 12 in. RMP ☒ PVC ☐ Weight ☐ lbs./ft. Dia. 5 in. to 75 ft. depth Wall Thickness: inches or Dia. ☐ in. to ☐ ft. depth Gauge No. 200	
					10. Screen Manufacturer's name Sunflower Plastic Type styrene Dia. 5" Slot/size /// .06 Length 60' Set between 15 ft. and 75 ft. Gravel pack? yes Size range of material 1-1/8"	
					11. Static water level: 15 ft. below land surface Date 8-17-76 mo./day/yr.	
					12. Pumping level below land surfaces: ____ ft. after ____ hrs. pumping ____ g.p.m. ____ ft. after ____ hrs. pumping ____ g.p.m. Estimated maximum yield ____ g.p.m.	
					13. Water sample submitted: ____ mo./day/yr. ☐ Yes ☐ No Date ____	
					14. Well head completion: 12 capped ☐ Pitless adapter ____ Inches above grade	
					15. Well grouted? yes With: ☒ Neat cement ☐ Bentonite ☒ Concrete Depth: From 40' ft. to 14' ft.	
					16. Nearest source of possible contamination: Septic ft. 60 Direction SE Type tank Well disinfected upon completion? ☒ Yes ☐ No	
					17. Pump: ☒ Not installed Manufacturer's name ____ Model number ____ HP ____ Volts ____ Length of drop pipe ____ ft. capacity ____ g.p.m. Type: ☐ Submersible ☐ Turbine ☐ Jet ☐ Reciprocating ☐ Centrifugal ☐ Other	
			(Use a second sheet if needed)			
18. Elevation:		19. Remarks:				
Topography: ☒ Hill ☐ Slope ☐ Upland ☐ Valley		20. Water well contractor's certification: This well was drilled under my jurisdiction and this report is true to the best of my knowledge and belief. Harp Well & Pump 236 Business name License No. Address Wichita, Kansas Signed M. Arnold Date 8-28-76 Authorized representative				

Forward the white, blue and pink copies to the Department of Health and Environment

Form WWC-5