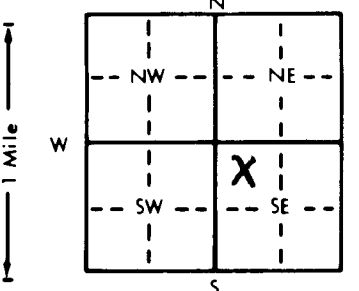


1 LOCATION OF WATER WELL:		Fraction	Section Number	Township Number	Range Number
County: <u>Sedgwick</u>		<u>NW 1/4 NW 1/4 SE 1/4</u>	<u>25</u>	<u>T 27 S</u>	<u>R 2 EW</u>
Distance and direction from nearest town or city street address of well if located within city? <u>2 1/2 mi. EAST of Wichita</u>					
2 WATER WELL OWNER: <u>KEN WRIGHT</u>		Board of Agriculture, Division of Water Resources			
RR#, St. Address, Box #: <u>1248 S. SAGEBRUSH</u>		Application Number:			
City, State, ZIP Code: <u>Wichita, Ks. 67230</u>					
3 LOCATE WELL'S LOCATION WITH AN "X" IN SECTION BOX:		4 DEPTH OF COMPLETED WELL: <u>60</u> ft. ELEVATION: _____			
		Depth(s) Groundwater Encountered 1. <u>50</u> ft. 2. _____ ft. 3. _____ ft.			
		WELL'S STATIC WATER LEVEL: <u>16</u> ft. below land surface measured on mo/day/yr <u>6/4/92</u>			
		Pump test data: Well water was _____ ft. after _____ hours pumping _____ gpm			
		Est. Yield <u>40</u> gpm Well water was _____ ft. after _____ hours pumping _____ gpm			
Bore Hole Diameter: <u>10</u> in. to _____ ft., and _____ in. to _____ ft.		WELL WATER TO BE USED AS:			
1 Domestic 3 Feedlot 6 Oil field water supply 9 Dewatering 12 Other (Specify below)		5 Public water supply 8 Air conditioning 11 Injection well			
2 Irrigation 4 Industrial 7 <u>Lawn and garden only</u> 10 Monitoring well					
Was a chemical/bacteriological sample submitted to Department? Yes _____ No _____; If yes, mo/day/yr sample was submitted _____		Water Well Disinfected? Yes _____ No _____			
5 TYPE OF BLANK CASING USED:					
1 Steel 3 RMP (SR) 5 Wrought iron 8 Concrete tile		CASING JOINTS: Glued _____ Clamped _____			
2 <u>PVC</u> 4 ABS 6 Asbestos-Cement 9 Other (specify below) Welded _____					
Blank casing diameter: <u>5</u> in. to _____ ft., Dia _____ in. to _____ ft., Dia _____ in. to _____ ft.		Threaded _____			
Casing height above land surface: <u>12</u> in., weight <u>160</u> lbs./ft. Wall thickness or gauge No. _____					
TYPE OF SCREEN OR PERFORATION MATERIAL:					
1 Steel 3 Stainless steel 5 Fiberglass 8 RMP (SR) 10 Asbestos-cement		11 Other (specify) _____			
2 Brass 4 Galvanized steel 6 Concrete tile 9 ABS 12 None used (open hole)					
SCREEN OR PERFORATION OPENINGS ARE:					
1 Continuous slot 2 <u>Mill slot</u> 5 Gauzed wrapped 8 Saw cut 11 None (open hole)					
2 Louvered shutter 4 Key punched 6 Wire wrapped 9 Drilled holes					
3 <u>40</u> ft. to <u>60</u> ft. 7 Torch cut 10 Other (specify) _____					
SCREEN-PERFORATED INTERVALS: From _____ ft. to _____ ft., From _____ ft. to _____ ft.					
GRAVEL PACK INTERVALS: From <u>20</u> ft. to <u>60</u> ft., From _____ ft. to _____ ft.					
6 GROUT MATERIAL: 1 Neat cement 2 Cement grout 3 <u>Bentonite</u> 4 Other _____					
Grout Intervals: From <u>0</u> ft. to <u>20</u> ft., From _____ ft. to _____ ft., From _____ ft. to _____ ft.					
What is the nearest source of possible contamination:					
1 Septic tank 4 Lateral lines 7 Pit privy 10 Livestock pens 14 Abandoned water well					
2 Sewer lines 5 Cess pool 8 Sewage lagoon 11 Fuel storage 15 Oil well/Gas well					
3 <u>Watertight sewer lines</u> 6 Seepage pit 9 Feedyard 12 Fertilizer storage 16 Other (specify below)					
13 Insecticide storage					
Direction from well? _____		How many feet? <u>15+</u>			
FROM	TO	LITHOLOGIC LOG	FROM	TO	PLUGGING INTERVALS
0	3	earth			
3	9	brown clay			
9	45	yellow clay			
45	50	broken grey lime			
50	60	shale lime			
7 CONTRACTOR'S OR LANDOWNER'S CERTIFICATION: This water well was (1) constructed, (2) reconstructed, or (3) plugged under my jurisdiction and was completed on (mo/day/year) <u>6/4/92</u> and this record is true to the best of my knowledge and belief. Kansas Water Well Contractor's License No. <u>493</u> This Water Well Record was completed on (mo/day/yr) _____ under the business name of <u>Rebecca Well Drilling</u> by (signature) <u>Janey Reiman</u>					
INSTRUCTIONS: Use typewriter or ball point pen. PLEASE PRESS FIRMLY and PRINT clearly. Please fill in blanks, underline or circle the correct answers. Send top three copies to Kansas Department of Health and Environment, Bureau of Water, Topeka, Kansas 66620-7320. Telephone: 913-296-5545. Send one to WATER WELL OWNER and retain one for your records.					