


1 LOCATION OF WATER WELL:		Fraction	NE	SE	NW	NE	Section Number	Township Number			Range Number		
County:	SEDGWICK	N 1/4	E 1/4	S 1/4	W 1/4		26	T	27	S	R	2 E	EW

14001 Lakeview Wichita, KS.

2	WATER WELL OWNER:	Rosemary Crowley	
	RR#, St. Address, Box # :	14001 Lakeview	Board of Agriculture, Division of Water Resources
	City, State, ZIP Code :	Wichita, Kansas	Application Number:

3	LOCATE WELL'S LOCATION WITH AN "X" IN SECTION BOX:	4	DEPTH OF COMPLETED WELL	80	ft.	ELEVATION:	
				28			

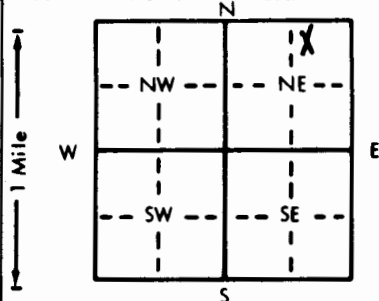

4 DEPTH OF COMPLETED WELL 80 ft. ELEVATION:
 Depth(s) Groundwater Encountered 1. 28 ft. 2. ft. 3. ft.
 WELL'S STATIC WATER LEVEL 28 ft. below land surface measured on mo/day/yr 4-13-88

Pump test data: Well water was ft. after hours pumping gpm
 Est. Yield gpm; Well water was ft. after hours pumping gpm
 Bore Hole Diameter 11 in. to ft., and in. to ft.

WELL WATER TO BE USED AS:		5 Public water supply	8 Air conditioning	11 Injection well
1 Domestic	3 Feedlot	6 Oil field water supply	9 Dewatering	12 Other (Specify below)
2 Irrigation	4 Industrial	7 Lawn and garden only	10 Monitoring well	

Was a chemical/bacteriological sample submitted to Department? Yes.....No.....X.....; If yes, mo/day/yr sample was submitted

5 TYPE OF BLANK CASING USED:		5 Wrought iron	8 Concrete tile	CASING JOINTS: Glued ☒	Clamped ☐
1 Steel	3 <u>RMP (SR)</u>	6 Asbestos-Cement	9 Other (specify below)	Welded ☒	
2 PVC	4 ABS	7 Fiberglass	Cer-Mac styrene SDR-26	Threaded ☐	
Blank casing diameter 5 in. to 30 ft. Dia		in. to ft. Dia in. to ft.			
Casing height above land surface 12 in., weight 1.59 lbs./ft.		Wall thickness or gauge No. 203			

TYPE OF SCREEN OR PERFORATION MATERIAL:			7 PVC	10 Asbestos-cement
1 Steel	3 Stainless steel	5 Fiberglass	8 <u>RMP (SR)</u>	11 Other (specify)
2 Brass	4 Galvanized steel	6 Concrete tile	9 ABS	12 None used (open hole)

SCREEN OR PERFORATION OPENINGS ARE:

1 Continuous slot	3 Mill slot	5 Gauzed wrapped	8 Saw cut	11 None (open hole)
2 Louvered shutter	4 Key punched	6 Wire wrapped	9 Drilled holes	
		7 Torch cut	10 Other (specify)	

SCREEN-PERFORATED INTERVALS:	From 30 ft. to 80 ft.	From 80 ft. to 100 ft.	From 100 ft. to 120 ft.
GRAVEL PACK INTERVALS:	From 24 ft. to 80 ft.	From 80 ft. to 100 ft.	From 100 ft. to 120 ft.

6 GROUT MATERIAL: 1 Neat cement 2 Cement grout 3 Bentonite 4 Other
Grout Intervals: From 4 ft. to 24 ft. From ft. to ft. From ft. to ft.

What is the nearest source of possible contamination:		10 Livestock pens	14 Abandoned water well
1 Septic tank	4 Lateral lines	11 Fuel storage	15 Oil well/Gas well
2 Sewer lines	5 Cess pool	12 Fertilizer storage	16 Other (specify below)
3 Watertight sewer lines	6 Seepage pit	13 Insecticide storage	
===== Direction from well?	East	How many feet?	25

[illegible]

7 CONTRACTOR'S OR LANDOWNER'S CERTIFICATION: This water well was (1) constructed, (2) reconstructed, or (3) plugged under my jurisdiction and was completed on (mo/day/year) 4-13-88 and this record is true to the best of my knowledge and belief. Kansas Water Well Contractor's License No. 236 This Water Well Record was completed on (mo/day/yr) 5-31-88 under the business name of Harp Well & Pump Service, Inc. by (signature) *Maris Arnold*

INSTRUCTIONS: Use typewriter or ball point pen. PLEASE PRESS FIRMLY and PRINT clearly. Please fill in blanks, underline or circle the correct answers. Send top three copies to Kansas Department of Health and Environment, Bureau of Water Protection, Topeka, Kansas 66620-7320. Telephone: 913-296-5514. Send one to WATER WELL OWNER and retain one for your records.