USE TYPEWRITER OR BALL POINT PEN-PRESS FIRMLY, PRINT CLEARLY.

WATER WELL RECORD
KSA 82a-1201-1215

Kansas Department of Health and Environment-Division of Environment
(Water well Contractors)
Topeka, Kansas 66620

1. Location of well:	County	Fraction	Section number	Township number	Range number
	SEDGWICK	NE SE1/4 NW1/4 SW1/4	27	T 27 S	R 2 (E) W

2. Distance and direction from nearest town or city:
Street address of well location if in city: 1001 Romney WICHITA, KANSAS

3. Owner of well: DON ASHEL
R.R. or street: 1001 Romney
City, state, zip code: WICHITA, KANSAS

4. Locate with "X" in section below: Sketch map:

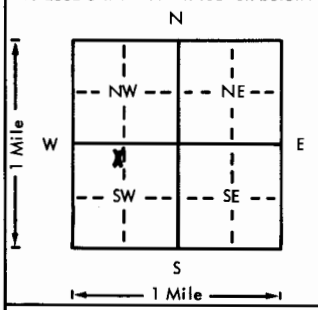

6. Bore hole dia. 11 in. Completion date 8-27-76
Well depth 65 ft.

7. __ Cable tool ✓ Rotary __ Driven __ Dug
__ Hollow rod __ Jetted __ Bored __ Reverse rotary

8. Use: __ Domestic __ Public supply __ Industry
__ Irrigation __ Air conditioning __ Stock
✓ Lawn __ Oil field water __ Other

9. Casing: Material STYRENE Weight: (Above) or below
Threaded __ Welded GL Surface 12 in.
RMP ✓ PVC __ Weight __ lbs./ft.
Dia. 5 in. to 65 ft. depth Wall Thickness: inches or
Dia. __ in. to __ ft. depth gage No. 200

5. Type and color of material	From	To
TOPSOIL	0	5
GRAY CLAY	5	25
SOFT LIGHT BROWN SHALE	25	65

(Use a second sheet if needed)

10. Screen: Manufacturer's name SUNFLOWER PLASTIC
Type STYRENE Dia. 5"
(Slot) gauze 106 Length 35'
Set between 30 ft. and 65 ft.
ft. and ft.
Gravel pack? YES Size range of material 1/4-1/8"

11. Static water level: mo./day/yr.
30 ft. below land surface Date 8-27-76

12. Pumping level below land surfaces:
ft. after hrs. pumping g.p.m.
ft. after hrs. pumping g.p.m.
Estimated maximum yield g.p.m.

13. Water sample submitted: mo./day/yr.
__ Yes __ No Date

14. Well head completion: CAPPED
__ Pitless adapter 12 Inches above grade

15. Well grouted? YES
With: __ Neat cement __ Bentonite ✓ Concrete
Depth: From 40" ft. to 14 ft.

16. Nearest source of possible contamination: SEPTIC
ft. 100 Direction WEST Type TANK
Well disinfected upon completion? ✓ Yes __ No

17. Pump: ✓ Not installed
Manufacturer's name
Model number HP Volts
Length of drop pipe ft. capacity g.p.m.
Type:
__ Submersible __ Turbine
__ Jet __ Reciprocating
__ Centrifugal __ Other

18. Elevation:
Topography:
__ Hill
__ Slope
__ Upland
__ Valley

19. Remarks: FLAT GROUND

20. Water well contractor's certification:
This well was drilled under my jurisdiction and this report is true to the best of my knowledge and belief.
HARP WELL & PUMP 236
Business name License No.
Address WICHITA KANSAS
Signed M. Arnold Date 9-30-76
Authorized representative

27 T 2 R (E) W 27 Sec NWSW 1/4 1/4 1/4

Forward the white, blue and pink copies to the Department of Health and Environment

Form WWC-5

MI-1023