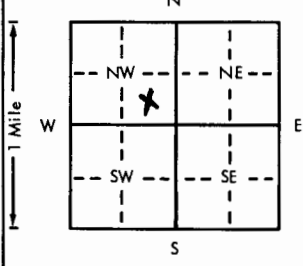


USE TYPEWRITER OR BALL
POINT PEN-PRESS FIRMLY,
PRINT CLEARLY.

WATER WELL RECORD
KSA 82a-1201-1215

Kansas Department of Health and
Environment-Division of Environment
(Water well Contractors)
Topeka, Kansas 66620

1. Location of well:		County Sedgwick	Fraction SE NE NW SW 1/4 SE 1/4 NW 1/4	Section number 27	Township number T 27 S R 2E E/W	Range number
2. Distance and direction from nearest town or city: Street address of well location if in city: 935 Romney Wichita, Kansas			3. Owner of well: Michael Sauerwein Constr. R.R. or street: 928 South Fountain City, state, zip code: Wichita, Kansas 67218			
4. Locate with "X" in section below: N 1 Mile W E S 1 Mile			Sketch map: 			
5. Type and color of material			From	To	6. Bore hole dia. 11 in. Completion date 10-13-77 Well depth 75 ft.	
					7. ☐ Cable tool ☒ Rotary ☐ Driven ☐ Dug ☐ Hollow rod ☐ Jetted ☐ Bored ☐ Reverse rotary	
					8. Use: ☐ Domestic ☐ Public supply ☐ Industry ☐ Irrigation ☐ Air conditioning ☐ Stock ☒ Lawn ☐ Oil field water ☐ Other	
					9. Casing: Material styrene Height: Above or below 1/4 Threaded ☐ Welded ☒ Surface 12 in. RMP ☒ PVC ☐ Weight ☐ lbs./ft. Dia. 5 in. to 75 ft. depth Wall Thickness: inches or Dia. ☐ in. to ☐ ft. depth gage No. 200	
					10. Screen: Manufacturer's name Sunflower Plastic Type styrene Dia. 5" Slot/gauge 1/4" .06 Length 55' Set between 20 ft. and 75 ft. ft. and 1/4-1/8" Gravel pack? yes Size range of material	
					11. Static water level: 19 ft. below land surface Date 10-13-77 mo./day/yr.	
					12. Pumping level below land surfaces: ft. after hrs. pumping g.p.m. ft. after hrs. pumping g.p.m. Estimated maximum yield g.p.m.	
					13. Water sample submitted: mo./day/yr. Yes ☐ No ☐ Date	
					14. Well head completion: well seal Pitless adapter 12 inches above grade	
					15. Well grouted? yes 1-2 fine sand mix With: ☐ Neat cement ☐ Bentonite ☒ Concrete Depth: From 40" ft. to 14 ft.	
					16. Nearest source of possible contamination: Septic ft. 150 Direction SW Type Tank Well disinfected upon completion? ☒ Yes ☐ No	
					17. Pump: Not installed Manufacturer's name Hydraulic Products Co. Model number F06C20 HP 1 1/2 Volts 230 Length of drop pipe 60 ft. capacity 35 g.p.m. Type: ☒ Submersible ☐ Turbine ☐ Jet ☐ Reciprocating ☐ Centrifugal ☐ Other	
			(Use a second sheet if needed)			
18. Elevation:		19. Remarks: Flat Ground				
Topography: ☐ Hill ☐ Slope ☐ Upland ☐ Valley		20. Water well contractor's certification: This well was drilled under my jurisdiction and this report is true to the best of my knowledge and belief. Harp Well & Pump 236 Business name Wichita, Kansas License No. Address Signed M. Arnold Date 10-13-77 Authorized representative 11-10-77 Form WWC-5				

Forward the white, blue and pink copies to the Department of Health and Environment