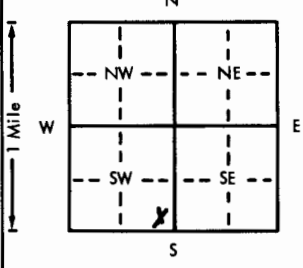


USE TYPEWRITER OR BALL
POINT PEN-PRESS FIRMLY,
PRINT CLEARLY.

WATER WELL RECORD
KSA 82a-1201-1215

Kansas Department of Health and
Environment-Division of Environment
(Water well Contractors)
Topeka, Kansas 66620

1. Location of well: <u>Sedgwick</u>		Fraction: <u>1/4 SE 1/4 SW 1/4</u>	Section number: <u>34</u>	Township number: <u>T 27 S</u>	Range number: <u>R 2 E</u>
2. Distance and direction from nearest town or city: <u>3111 Richfield</u>		3. Owner of well: <u>Don Thomas</u>			
Street address of well location if in city: <u>Richfield, Ks.</u>		City, state, zip code: <u>Richfield, Kansas</u>			
4. Locate with "X" in section below: 		Sketch map:		6. Bore hole dia. <u>69</u> in. Completion date: <u>5-1-76</u> Well depth <u>69</u> ft.	
5. Type and color of material		From	To	7. ☒ Cable tool ☒ Rotary ☐ Driven ☐ Dug ☐ Hollow rod ☐ Jetted ☐ Bored ☐ Reverse rotary	
<u>Sandy Topsoil</u>		<u>0</u>	<u>2</u>	8. Use: ☐ Domestic ☐ Public supply ☐ Industry ☒ Irrigation ☐ Air conditioning ☐ Stock ☒ Lawn ☐ Oil field water ☐ Other	
<u>Clay</u>		<u>2</u>	<u>45</u>	9. Casing: Material: <u>STYRENE</u> Weight: <u>12</u> lbs./ft. Threaded ☒ Welded ☒ Surface ☐ Dia. <u>5</u> in. RMP ☒ PVC ☐ Weight: <u>106</u> lbs./ft. Dia. <u>5</u> in. to <u>69</u> ft. depth Wall Thickness: inches or Dia. <u>5</u> in. to <u>69</u> ft. depth gage No. <u>1200</u>	
<u>Shale</u>		<u>45</u>	<u>69</u>	10. Screen: Manufacturer's name: <u>SUNFLOWER PLASTIC</u> Type: <u>STYRENE</u> Dia. <u>5</u> in. Slot/gauze: <u>106</u> Length: <u>45</u> ft. Set between <u>24</u> ft. and <u>69</u> ft. ft. and <u>69</u> ft. Gravel pack? <u>YES</u> Size range of material: <u>1/4-1/8"</u>	
				11. Static water level: <u>27</u> ft. below land surface Date: <u>5-1-76</u> mo./day/yr.	
				12. Pumping level below land surfaces: ____ ft. after ____ hrs. pumping ____ g.p.m. ____ ft. after ____ hrs. pumping ____ g.p.m. Estimated maximum yield ____ g.p.m.	
				13. Water sample submitted: ____ mo./day/yr. Yes ____ No ____ Date ____	
				14. Well head completion: <u>12 Capped</u> Pitless adapter ____ Inches above grade	
				15. Well grouted? <u>YES</u> With: ☒ Neat cement ☒ Bentonite ☒ Concrete Depth: From <u>40</u> ft. to <u>14</u> ft.	
				16. Nearest source of possible contamination: <u>Septic Tank</u> ft. <u>51</u> Direction: <u>South</u> type ____ Well disinfected upon completion? ☒ Yes ____ No	
				17. Pump: ☒ Not installed Manufacturer's name ____ Model number ____ HP ____ Volts ____ Length of drop pipe ____ ft. capacity ____ g.p.m. Type: ☐ Submersible ☐ Turbine ☐ Jet ☐ Reciprocating ☐ Centrifugal ☐ Other	
18. Elevation:		19. Remarks: <u>Flat Ground</u>		20. Water well contractor's certification: This well was drilled under my jurisdiction and this report is true to the best of my knowledge and belief. <u>HARPWELL + PUMP</u> Ser <u>233</u> Business name: <u>WICHITA, KANSAS</u> License No. ____ Address: <u>W. Arnold</u> Date: <u>6-15-76</u> Signed: <u>W. Arnold</u> Authorized representative	

Forward the white, blue and pink copies to the Department of Health and Environment

Form WWC-5