


4 DEPTH OF COMPLETED WELL... 80 ... ft. ELEVATION: ...
Depth(s) Groundwater Encountered: 1 ... ft 2 ... ft 3 ... ft

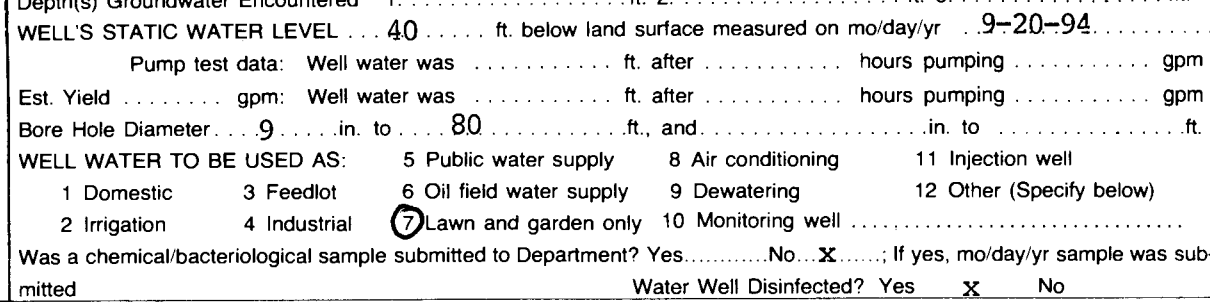

TYPE OF SCREEN OR PERFORATION MATERIAL:				7 ☒ PVC	10 Asbestos-cement
1 Steel	3 Stainless steel	5 Fiberglass	8 RMP (SR)	11 Other (specify)	
2 Brass	4 Galvanized steel	6 Concrete tile	9 ABS	12 None used (open hole)	
SCREEN OR PERFORATION OPENINGS ARE:			5 Gauzed wrapped	8 ☒ Saw cut	11 None (open hole)
1 Continuous slot	3 Mill slot	6 Wire wrapped	9 Drilled holes		
2 Louvered shutter	4 Key punched	7 Torch cut	10 Other (specify)		
SCREEN-PERFORATED INTERVALS:		From 20 ft. to 80 ft.	From ft. to ft.	From ft. to ft.	From ft. to ft.
GRAVEL PACK INTERVALS:		From 20 ft. to 30 ft.	From ft. to ft.	From ft. to ft.	From ft. to ft.

6 GROUT MATERIAL:		1 Neat cement	2 Cement grout	3 Bentonite	4 Other
Grout Intervals:		From 4 ft. to 20 ft.	From	ft. to	ft.
What is the nearest source of possible contamination:			10 Livestock pens		
1 Septic tank	4 Lateral lines	7 Pit privy	14 Abandoned water well		
2 Sewer lines	5 Cess pool	8 Sewage lagoon	11 Fuel storage		
3 Watertight sewer lines	6 Seepage pit	9 Feedyard	12 Fertilizer storage		
			13 Insecticide storage		
Direction from well?			How many feet?		

[illegible]

7 CONTRACTOR'S OR LANDOWNER'S CERTIFICATION: This water well was (1) constructed, (2) reconstructed, or (3) plugged under my jurisdiction and was completed on (mo/day/year) 9-20-94 and this record is true to the best of my knowledge and belief. Kansas Water Well Contractor's License No. 171 This Water Well Record was completed on (mo/day/yr) 9-28-94 under the business name of G & S Drilling by (signature) 