


WATER WELL RECORD Form WWC-5 KSA 82a-1212

1 LOCATION OF WATER WELL: Fraction SE 1/4 SE 1/4 SE 1/4 Section Number 19 Township Number T 27 S Range Number R 2 EAST
 County: Sedgwick
 Distance and direction from nearest town or city street address of well if located within city? Intersection of Main and Maple St., Wichita, Kansas ?

2 WATER WELL OWNER: Amoco Oil Co.
 RR#, St. Address, Box #: 8700 Indian Creek Parkway, Suite 190 Board of Agriculture, Division of Water Resources
 City, State, ZIP Code: Overland Park, Kansas 66210 Application Number:

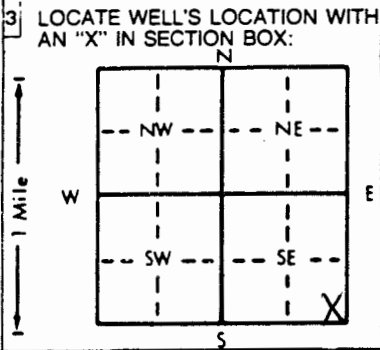

4 DEPTH OF COMPLETED WELL: 12 ft. ELEVATION:
 Depth(s) Groundwater Encountered 1. . . . ft. 2. . . . ft. 3. . . . ft.
 WELL'S STATIC WATER LEVEL ft. below land surface measured on mo/day/yr
 Pump test data: Well water was ft. after hours pumping gpm
 Est. Yield gpm: Well water was ft. after hours pumping gpm
 Bore Hole Diameter 8. . . . in. to 12. . . . ft., and in. to ft.
 WELL WATER TO BE USED AS: 5 Public water supply 8 Air conditioning 11 Injection well
 1 Domestic 3 Feedlot 6 Oil field water supply 9 Dewatering 12 Other (Specify below)
 2 Irrigation 4 Industrial 7 Lawn and garden only 10 Monitoring well
 Was a chemical/bacteriological sample submitted to Department? Yes No X ; If yes, mo/day/yr sample was submitted
 Water Well Disinfected? Yes No X

5 TYPE OF BLANK CASING USED: 5 Wrought iron 8 Concrete tile CASING JOINTS: Glued Clamped
 1 Steel 3 RMP (SR) 6 Asbestos-Cement 9 Other (specify below) Welded
 (2) PVC 4 ABS 7 Fiberglass Threaded. X
 Blank casing diameter 2. . . . in. to 5. . . . ft., Dia in. to ft., Dia in. to ft.
 Casing height above land surface 0 in., weight lbs./ft. Wall thickness or gauge No. . . . sch. 40
 TYPE OF SCREEN OR PERFORATION MATERIAL: (7) PVC 10 Asbestos-cement
 1 Steel 3 Stainless steel 5 Fiberglass 8 RMP (SR) 11 Other (specify)
 2 Brass 4 Galvanized steel 6 Concrete tile 9 ABS 12 None used (open hole)
 SCREEN OR PERFORATION OPENINGS ARE: 5 Gauzed wrapped 8 Saw cut 11 None (open hole)
 1 Continuous slot (3) Mill slot 6 Wire wrapped 9 Drilled holes
 2 Louvered shutter 4 Key punched 7 Torch cut 10 Other (specify)
 SCREEN-PERFORATED INTERVALS: From 12 ft. to 5 ft., From ft. to ft.
 GRAVEL PACK INTERVALS: From 12 ft. to 5 ft., From ft. to ft.

6 GROUT MATERIAL: 1 Neat cement (2) Cement grout (3) Bentonite 4 Other
 Grout Intervals: From 5 ft. to 3 ft., From 3 ft. to 0 ft., From ft. to ft.
 What is the nearest source of possible contamination: 10 Livestock pens 14 Abandoned water well
 1 Septic tank 4 Lateral lines 7 Pit privy 11 Fuel storage 15 Oil well/Gas well
 2 Sewer lines 5 Cess pool 8 Sewage lagoon 12 Fertilizer storage (16) Other (specify below)
 3 Watertight sewer lines 6 Seepage pit 9 Feedyard 13 Insecticide storage UST.
 Direction from well? How many feet? 10

LITHOLOGIC LOG			PLUGGING INTERVALS		
FROM	TO		FROM	TO	
0	2	Clay, greenish brown			
2	7	Sand, fine to coarse			
7	11	Sand, medium to coarse			
11	12	Clay, some sand			

7 CONTRACTOR'S OR LANDOWNER'S CERTIFICATION: This water well was (1) constructed, (2) reconstructed, or (3) plugged under my jurisdiction and was completed on (mo/day/year) 04-06-94 and this record is true to the best of my knowledge and belief. Kansas Water Well Contractor's License No. 527. This Water Well Record was completed on (mo/day/year) 12-28-94 under the business name of GeoCore Services, Inc. by (signature) [Signature]