

1 LOCATION OF WATER WELL:

County: Berthier

Fraction

WE $\frac{1}{4}$ NW $\frac{1}{4}$ NW $\frac{1}{4}$

Section Number

19

Township Number

T 27 S

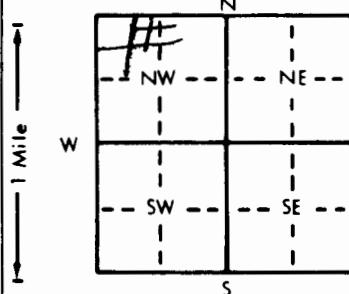
Range Number

R 3 EW

Distance and direction from nearest town or city street address of well if located within city?

Andover Kan

2 WATER WELL OWNER:

RR#, St. Address, Box # 522 Angle Ln.City, State, ZIP Code Andover Kan 67002Board of Agriculture, Division of Water Resources
Application Number:3 LOCATE WELL'S LOCATION WITH
AN "X" IN SECTION BOX:4 DEPTH OF COMPLETED WELL. 105 ft. ELEVATION:Depth(s) Groundwater Encountered 1.90 ft. 2. ft. 3. ft.WELL'S STATIC WATER LEVEL .35 ft. below land surface measured on mo/day/yr

Pump test data: Well water was ft. after hours pumping gpm

Est. Yield .40 gpm Well water was ft. after hours pumping gpmBore Hole Diameter .75 in. to ft. and in. to ft.

WELL WATER TO BE USED AS: 5 Public water supply 8 Air conditioning 11 Injection well

1 Domestic 3 Feedlot 6 Oil field water supply 9 Dewatering 12 Other (Specify below)

2 Irrigation 4 Industrial 7 Lawn and garden only 10 Monitoring wellWas a chemical/bacteriological sample submitted to Department? Yes No If yes, mo/day/yr sample was submittedWater Well Disinfected? Yes No

5 TYPE OF BLANK CASING USED:

1 Steel 3 RMP (SR)

5 Wrought iron

8 Concrete tile

CASING JOINTS: Glued Clamped PVC 4 ABS

6 Asbestos-Cement

9 Other (specify below)

Welded

Blank casing diameter 3 in. to 40 ft. Dia. in. to ft. Dia. in. to ft.

7 Fiberglass

Threaded

Casing height above land surface 18 in. weight 160 lbs./ft. Wall thickness or gauge No. 12.14

TYPE OF SCREEN OR PERFORATION MATERIAL:

1 Steel 3 Stainless steel

5 Fiberglass

8 RMP (SR)

10 Asbestos-cement

2 Brass 4 Galvanized steel

6 Concrete tile

9 ABS

11 Other (specify)

SCREEN OR PERFORATION OPENINGS ARE:

1 Continuous slot 3 Mill slot

5 Gauzed wrapped

8 Saw cut

11 None (open hole)

2 Louvered shutter 4 Key punched

6 Wire wrapped

9 Drilled holes

SCREEN-PERFORATED INTERVALS: From 40 ft. to 105 ft. From ft. to ft. From ft. to ft.

7 Torch cut

10 Other (specify)

GRAVEL PACK INTERVALS: From ft. to ft. From ft. to ft. From ft. to ft.

From ft. to ft. From ft. to ft. From ft. to ft.

6 GROUT MATERIAL: 1 Neat cement 2 Cement grout 3 Bentonite 4 OtherGrout Intervals: From 0 ft. to 23 ft. From ft. to ft. From ft. to ft. From ft. to ft.

What is the nearest source of possible contamination:

1 Septic tank 4 Lateral lines

7 Pit privy

10 Livestock pens

14 Abandoned water well

2 Sewer lines 5 Cess pool

8 Sewage lagoon

11 Fuel storage

15 Oil well/Gas well

 3 Watertight sewer lines 6 Seepage pit

9 Feedyard

12 Fertilizer storage

16 Other (specify below)

Direction from well?

E

LITHOLOGIC LOG

3

4

PLUGGING INTERVALS

FROM 0 TO 4 SOILFROM 4 TO 25 CLAYFROM 25 TO 105 SHALE & LIME

5

6

7 CONTRACTOR'S OR LANDOWNER'S CERTIFICATION: This water well was (1) constructed, (2) reconstructed, or (3) plugged under my jurisdiction and was completed on (mo/day/year) 9/19/96 and this record is true to the best of my knowledge and belief. Kansas Water Well Contractor's License No. 251 This Water Well Record was completed on (mo/day/year) 9/18/00 by (signature) Charles Winter