

251141 MW-8

WATER WELL RECORD Form WWC-5 KSA 82a-1212

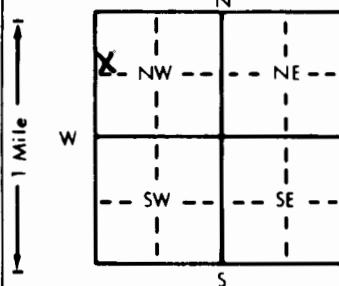
1 LOCATION OF WATER WELL:	Fraction County: Butler	SW $\frac{1}{4}$ NW $\frac{1}{4}$ NW $\frac{1}{4}$	Section Number T 27 S	Township Number R 3 NW	Range Number
---------------------------	----------------------------	--	--------------------------	---------------------------	--------------

Distance and direction from nearest town or city street address of well if located within city?

42°N, 121°W of NW corner of 404 residence

2 WATER WELL OWNER:	Coastal Mart, Inc.	RR#, St. Address, Box #	110 S. Main, Suite 500	Board of Agriculture, Division of Water Resources
City, State, ZIP Code	Wichita, KS 67202	Application Number:		

3 LOCATE WELL'S LOCATION WITH AN "X" IN SECTION BOX:	4 DEPTH OF COMPLETED WELL:	25.5 ft. ELEVATION: 1347.34
--	----------------------------	-----------------------------

	Depth(s) Groundwater Encountered	1 ft. 2 ft. 3 ft.
	WELL'S STATIC WATER LEVEL	ft. below land surface measured on mo/day/yr
	Pump test data: Well water was	ft. after hours pumping gpm
	Est. Yield gpm: Well water was	ft. after hours pumping gpm
	Bore Hole Diameter 8 in. to 25.5 ft. and in. to ft.	
	WELL WATER TO BE USED AS:	5 Public water supply 8 Air conditioning 11 Injection well
	1 Domestic 3 Feedlot 6 Oil field water supply 9 Dewatering 12 Other (Specify below)	
	2 Irrigation 4 Industrial 7 Lawn and garden only 10 Monitoring well	
	Was a chemical/bacteriological sample submitted to Department? Yes No X	If yes, mo/day/yr sample was submitted
	Water Well Disinfected? Yes	No X

5 TYPE OF BLANK CASING USED:	5 Wrought iron	8 Concrete tile	CASING JOINTS: Glued	Clamped
1 Steel 3 RMP (SR)	6 Asbestos-Cement	9 Other (specify below)	Welded	Threaded

Blank casing diameter 2 in. to 15.5 ft. Dia. in. to ft. Dia. in. to ft.

Casing height above land surface flush in., weight 0.703 lbs./ft. Wall thickness or gauge No. Sch 40

TYPE OF SCREEN OR PERFORATION MATERIAL:	7 PVC	10 Asbestos-cement
1 Steel 3 Stainless steel	5 Fiberglass	11 Other (specify)
2 Brass 4 Galvanized steel	6 Concrete tile	12 None used (open hole)

SCREEN OR PERFORATION OPENINGS ARE:	5 Gauzed wrapped	8 Saw cut	11 None (open hole)
1 Continuous slot 3 Mill slot	6 Wire wrapped	9 Drilled holes	
2 Louvered shutter 4 Key punched	7 Torch cut	10 Other (specify)	

SCREEN-PERFORATED INTERVALS:	From 15.5 ft. to 25.5 ft.	From ft. to ft.	From ft. to ft.
GRAVEL PACK INTERVALS:	From 13.5 ft. to 25.5 ft.	From ft. to ft.	From ft. to ft.

6 GROUT MATERIAL:	1 Neat cement	2 Cement grout	3 Bentonite	4 Other
Grout Intervals:	From 1 ft. to 13.5 ft.	From ft. to ft.	From ft. to ft.	From ft. to ft.

What is the nearest source of possible contamination:

1 Septic tank	4 Lateral lines	7 Pit privy	10 Livestock pens	14 Abandoned water well
2 Sewer lines	5 Cess pool	8 Sewage lagoon	11 Fuel storage	15 Oil well/Gas well
3 Watertight sewer lines	6 Seepage pit	9 Feedyard	12 Fertilizer storage	16 Other (specify below)

Direction from well?

FROM	TO	LITHOLOGIC LOG	FROM	TO	PLUGGING INTERVALS
0	2	Clay, h-m plasticity			
2	10	Clay/ weathered shale			
10	25.5	Limestone and clay			

7 CONTRACTOR'S OR LANDOWNER'S CERTIFICATION: This water well was (1) constructed, (2) reconstructed, or (3) plugged under my jurisdiction and was completed on (mo/day/year) 9-9-98 and this record is true to the best of my knowledge and belief. Kansas

Water Well Contractor's License No. 531 This Water Well Record was completed on (mo/day/yr) 10-7-98 under the business name of Geotechnical Services, Inc. (GSI) by (signature) 