

| | | | | |
|---------------------------|-----------------------------------|--|---------------------------|------------------------|
| 1 LOCATION OF WATER WELL: | Fraction County: <i>Butler</i> | Section Number 1/4 NW 1/4 SW 1/4 17 | Township Number T 27 S | Range Number R 3 NW |
|---------------------------|-----------------------------------|--|---------------------------|------------------------|

Distance and direction from nearest town or city street address of well if located within city?

324 Lake Crest


2 WATER WELL OWNER: *Larry Stephenson*

RR#, St. Address, Box # *324 Lake Crest*

City, State, ZIP Code *Andover, KS 67002*

Board of Agriculture, Division of Water Resources
Application Number:

3 LOCATE WELL'S LOCATION WITH AN "X" IN SECTION BOX:

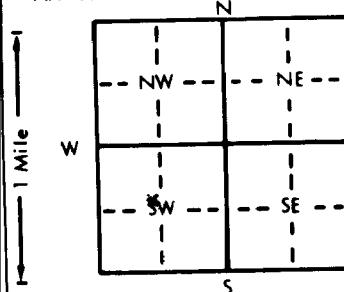

4 DEPTH OF COMPLETED WELL *120* ft. ELEVATION:

Depth(s) Groundwater Encountered 1. ft. 2. ft. 3. ft.

WELL'S STATIC WATER LEVEL ft. below land surface measured on mo/day/yr

Pump test data: Well water was ft. after hours pumping gpm

Est. Yield *70-85* gpm: Well water was ft. after hours pumping gpm

Bore Hole Diameter *10* in. to *120* ft., and in. to ft.

WELL WATER TO BE USED AS: 5 Public water supply 8 Air conditioning 11 Injection well

1 Domestic 3 Feedlot 6 Oil field water supply 9 Dewatering 12 Other (Specify below)

2 Irrigation 4 Industrial *Lawn and garden only* 10 Monitoring well

Was a chemical/bacteriological sample submitted to Department? Yes No If yes, mo/day/yr sample was submitted

Water Well Disinfected? Yes No

5 TYPE OF BLANK CASING USED:

1 Steel *Steel* 3 RMP (SR) 4 ABS

5 Wrought iron

8 Concrete tile

CASING JOINTS: Glued

Clamped

6 Asbestos-Cement

9 Other (specify below)

Welded

7 Fiberglass

Threaded

Blank casing diameter *6* in. to *2* ft., Dia *5* in. to *100* ft., Dia in. to ft.

Casing height above land surface *18* in., weight lbs./ft. Wall thickness or gauge No *SDR 26*

TYPE OF SCREEN OR PERFORATION MATERIAL:

1 Steel 3 Stainless steel 5 Fiberglass 8 RMP (SR)

6 Asbestos-Cement

9 ABS

10 Asbestos-cement

2 Brass 4 Galvanized steel

1 Continuous slot *3 Mill slot*

5 Gauzed wrapped

8 Saw cut

11 None (open hole)

2 Louvered shutter 4 Key punched

6 Wire wrapped

6 Wire wrapped

9 Drilled holes

12 None used (open hole)

SCREEN OR PERFORATION OPENINGS ARE:

1 Continuous slot *3 Mill slot*

2 Louvered shutter

4 Key punched

5 Gauzed wrapped

6 Wire wrapped

7 Torch cut

8 Saw cut

9 Drilled holes

10 Other (specify)

SCREEN-PERFORATED INTERVALS: From *100* ft. to *120* ft., From ft. to ft.

From ft. to ft., From ft. to ft.

ft. to ft.