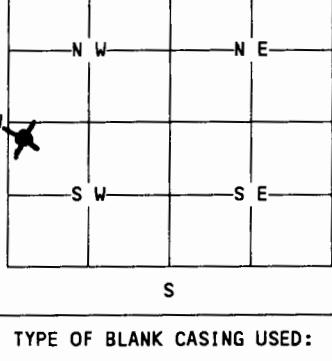


1 LOCATION OF WATER WELL:	Fraction	Section Number	Township Number	Range Number																				
County: Butler	NW1/4 NW1/4 SW1/4	1	27	3																				
Distance and direction from nearest town or city street address of well if located within city? 2 miles North & 4 miles East of Andover, KS																								
2 WATER WELL OWNER:	Mike Nelson																							
RR#, St. Address, Box #:	6600 SW Church St.																							
City, State, ZIP Code :	Andover, KS 67002																							
3 MARK WELL'S LOCATION WITH AN "X" IN SECTION BOX:	4 DEPTH OF WELL 200-200-200-200-200-200 WELL'S STATIC WATER LEVEL.....ft. WELL WAS USED AS: <table> <tr><td>1 Domestic</td><td>5 Public Water Supply</td><td>9 Dewatering</td></tr> <tr><td>2 Irrigation</td><td>6 Oil Field Water Supply</td><td>10 Monitoring Well</td></tr> <tr><td>3 Feedlot</td><td>7 Lawn and Garden Only</td><td>11 Injection Well</td></tr> <tr><td>4 Industrial</td><td>8 Air Conditioning</td><td>12 Other.....Heat Pump</td></tr>
 Was a chemical/bacteriological sample submitted to Department? Yes....No. X . If yes, mo/day/yr sample was submitted..... Water Well Disinfected: Yes..... No.... X .																								
5 TYPE OF BLANK CASING USED:	1 Steel 3 RMP (SR) 5 Wrought 7 Fiberglass 9 Other (specify below) X PVC 4 ABS 6 Asbestos-Cement 8 Concrete Tile																							
Blank casing diameter.... 3/4in. Was casing pulled? Yes..... No. X If yes, how much..... Casing height above or below land surface.....in.																								
6 GROUT PLUG MATERIAL:	1 Neat cement 2 Cement grout X Bentonite 4 Other..... Grout Plug Intervals: From.... 0ft. to 200ft., From.... 0ft. to 200ft., From.... 0ft. to 200ft. 0 200 0 200																							
What is the nearest source of possible contamination: <table> <tr><td>1 Septic tank</td><td>6 Seepage pit</td><td>11 Fuel storage</td><td>16 Other (specify below)</td></tr> <tr><td>X Sewer lines</td><td>7 Pit privy</td><td>12 Fertilizer storage</td><td>.....</td></tr> <tr><td>3 Watertight sewer lines</td><td>8 Sewage lagoon</td><td>13 Insecticide storage</td><td>.....</td></tr> <tr><td>4 Lateral lines</td><td>9 Feedyard</td><td>14 Abandoned water well</td><td>.....</td></tr> <tr><td>5 Cess Pool</td><td>10 Livestock pens</td><td>15 Oil well/Gas well</td><td>.....</td></tr> </table>					1 Septic tank	6 Seepage pit	11 Fuel storage	16 Other (specify below)	X Sewer lines	7 Pit privy	12 Fertilizer storage	3 Watertight sewer lines	8 Sewage lagoon	13 Insecticide storage	4 Lateral lines	9 Feedyard	14 Abandoned water well	5 Cess Pool	10 Livestock pens	15 Oil well/Gas well
1 Septic tank	6 Seepage pit	11 Fuel storage	16 Other (specify below)																					
X Sewer lines	7 Pit privy	12 Fertilizer storage																					
3 Watertight sewer lines	8 Sewage lagoon	13 Insecticide storage																					
4 Lateral lines	9 Feedyard	14 Abandoned water well																					
5 Cess Pool	10 Livestock pens	15 Oil well/Gas well																					
Direction from well? South			How many feet? 100																					
FROM	TO	PLUGGING MATERIALS																						
0	3	Topsoil																						
3	12	Tan Clay																						
12	24	Gray Shale																						
24	32	Red Shale																						
32	55	Gray Shale																						
55	62	Light Gray Shale																						
62	63	Fracture																						
7	CONTRACTOR'S OR LANDOWNER'S CERTIFICATION: This water well was plugged under my jurisdiction and was completed on (mo/day/year).... 12/20/99 and this record is true to the best of my knowledge and belief. Kansas Water Well Contractor's License No. 128 This Water Well Record was completed on (mo/day/year).... 17/1/2000 under the business name of Peterson Irrigation, Inc. by (signature) Mike Nelson																							