

1 LOCATION OF WATER WELL: County: Butler	Fraction C $\frac{1}{4}$ NE $\frac{1}{4}$ SW $\frac{1}{4}$	Section Number 17	Township Number T 27 S	Range Number R 3 E
--	--	-----------------------------	----------------------------------	------------------------------

Distance and direction from nearest town or city street address of well if located within city?

636 N. Westchester, Andover, KS

2 WATER WELL OWNER:

RR#, St. Address, Box # :

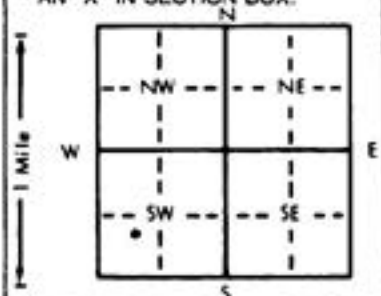
City, State, ZIP Code :

Allen Ceyner
636 N. Westchester
Andover, KS 67002

Board of Agriculture, Division of Water Resources

Application Number:

3 LOCATE WELL'S LOCATION WITH AN "X" IN SECTION BOX:

4 DEPTH OF COMPLETED WELL: **92** ft. ELEVATION:

Depth(s) Groundwater Encountered 1. ft. 2. ft. 3. ft.

WELL'S STATIC WATER LEVEL **24** ft. below land surface measured on mo/day/yr **4/28/00**

Pump test data: Well water was ft. after hours pumping gpm

Est. Yield gpm: Well water was ft. after hours pumping gpm

Bore Hole Diameter 9 in. to 92 ft., and in. to ft.

WELL WATER TO BE USED AS: 5 Public water supply 8 Air conditioning 11 Injection well

1 Domestic 3 Feedlot 6 Oil field water supply 9 Dewatering 12 Other (Specify below)

2 Irrigation 4 Industrial **17** Lawn and garden only 10 Monitoring wellWas a chemical/bacteriological sample submitted to Department? Yes No **X** If yes, mo/day/yr sample was sub-mitted Water Well Disinfected? Yes **X** No

5 TYPE OF BLANK CASING USED:

1 Steel 3 RMP (SR) 5 Wrought iron 8 Concrete tile CASING JOINTS: Glued **X** Clamped**2** PVC 4 ABS 6 Asbestos-Cement 9 Other (specify below) Welded

Blank casing diameter 5 in. to 62 ft. Dia. in. to ft. Dia. in. to ft.

Casing height above land surface 15 in. weight lbs./ft. Wall thickness or gauge No. **SDR26**

TYPE OF SCREEN OR PERFORATION MATERIAL:

1 Steel 3 Stainless steel 5 Fiberglass **17** PVC 10 Asbestos-cement

2 Brass 4 Galvanized steel 6 Concrete tile 9 ABS 11 Other (specify)

SCREEN OR PERFORATION OPENINGS ARE: 5 Gauzed wrapped 8 Saw cut 11 None (open hole)

1 Continuous slot **3** Mill slot 6 Wire wrapped 9 Drilled holes

2 Louvered shutter 4 Key punched 7 Torch cut 10 Other (specify)

SCREEN-PERFORATED INTERVALS: From 62 ft. to 92 ft. From ft. to ft.

From ft. to ft. From ft. to ft.

GRAVEL PACK INTERVALS: From 20 ft. to 92 ft. From ft. to ft.

From ft. to ft. From ft. to ft.

6 GROUT MATERIAL: 1 Neat cement 2 Cement grout **3** Bentonite 4 Other

Grout intervals: From 4 ft. to 20 ft. From ft. to ft. From ft. to ft.

What is the nearest source of possible contamination:

1 Septic tank 4 Lateral lines 7 Pit privy 10 Livestock pens 14 Abandoned water well

2 Sewer lines 5 Cess pool 8 Sewage lagoon 11 Fuel storage 15 Oil well/Gas well

3 Watertight sewer lines 6 Seepage pit 9 Feedyard 12 Fertilizer storage 16 Other (specify below)

Direction from well? How many feet?

FROM TO LITHOLOGIC LOG FROM TO PLUGGING INTERVALS

0 25 Clay

25 35 Shale

35 38 Lime

38 54 Shale

54 70 Lime and Shale

70 85 Lime

85 92 Cherty Lime

7 CONTRACTOR'S OR LANDOWNER'S CERTIFICATION: This water well was **(1)** constructed, (2) reconstructed, or (3) plugged under my jurisdiction and was completed on (mo/day/year) **4/28/00** and this record is true to the best of my knowledge and belief. KansasWater Well Contractor's License No. **171** This Water Well Record was completed on (mo/day/year) **4/30/00**under the business name of **G&S Drilling, Inc.** by (signature) **M. E. Brandt**