

WATER WELL RECORD Form WWC-5 KSA 82a-1212

1 LOCATION OF WATER WELL:

Fraction

SW $\frac{1}{4}$ SW $\frac{1}{4}$ NW $\frac{1}{4}$

Section Number

17

Township Number

T 27 S

Range Number

R 3E E/W

Distance and direction from nearest town or city street address of well if located within city?

Andover Rd. + Commerce ST, south side

2 WATER WELL OWNER:

Bill King

RR#, St. Address, Box #:

118 Ira Ct.


Board of Agriculture, Division of Water Resources

City, State, ZIP Code:

Andover, KS 67002

Application Number:

3 LOCATE WELL'S LOCATION WITH AN "X" IN SECTION BOX:

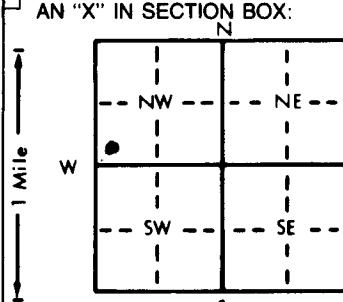

4 DEPTH OF COMPLETED WELL.....

ft. ELEVATION:.....

Depth(s) Groundwater Encountered 1..... ft. 2..... ft. 3..... ft.

WELL'S STATIC WATER LEVEL

28

ft. below land surface measured on mo/day/yr

5-3-01

Pump test data: Well water was ft. after hours pumping gpm

Est. Yield gpm: Well water was ft. after hours pumping gpm

Bore Hole Diameter 9 in. to 90 ft., and in. to ft.

WELL WATER TO BE USED AS: 5 Public water supply 8 Air conditioning 11 Injection well

1 Domestic 3 Feedlot 6 Oil field water supply 9 Dewatering 12 Other (Specify below)

2 Irrigation 4 Industrial 7 Lawn and garden only 10 Monitoring well

Was a chemical/bacteriological sample submitted to Department? Yes..... No If yes, mo/day/yr sample was submittedWater Well Disinfected? Yes No

5 TYPE OF BLANK CASING USED:

5 Wrought iron

CASING JOINTS: Glued Clamped

1 Steel 3 RMP (SR)

6 Asbestos-Cement

Welded

2 PVC 4 ABS

7 Fiberglass

Threaded

Blank casing diameter 5 in. to 70 ft., Dia in. to ft., Dia in. to ft.

Casing height above land surface 12 in., weight lbs./ft. Wall thickness or gauge No. SDR26

TYPE OF SCREEN OR PERFORATION MATERIAL:

7 PVC

10 Asbestos-cement

1 Steel

3 Stainless steel

5 Fiberglass

8 RMP (SR)

11 Other (specify)

2 Brass

4 Galvanized steel

6 Concrete tile

9 ABS

12 None used (open hole)

SCREEN OR PERFORATION OPENINGS ARE:

1 Continuous slot

3 Mill slot

2 Louvered shutter

4 Key punched

5 Gauzed wrapped

8 Saw cut

11 None (open hole)

6 Wire wrapped

9 Drilled holes

7 Torch cut

10 Other (specify)

SCREEN-PERFORATED INTERVALS: From.....

70

ft. to 90

ft., From ft. to ft.

From.....

ft. to 90

ft., From ft. to ft.

GRAVEL PACK INTERVALS: From.....

20

ft. to 90

ft., From ft. to ft.

From.....

ft. to 90

ft., From ft. to ft.

6 GROUT MATERIAL: 1 Neat cement

2 Cement grout

3 Bentonite

4 Other

Grout Intervals: From..... 4 ft. to 20 ft., From ft. to ft., From ft. to ft.

What is the nearest source of possible contamination:

1 Septic tank 4 Lateral lines

7 Pit privy

10 Livestock pens

14 Abandoned water well

2 Sewer lines 5 Cess pool

8 Sewage lagoon

11 Fuel storage

15 Oil well/Gas well

3 Watertight sewer lines 6 Seepage pit

9 Feedyard

12 Fertilizer storage

16 Other (specify below)

9 Insecticide storage

13 Insecticide storage

How many feet?

Direction from well?

FROM TO LITHOLOGIC LOG FROM TO PLUGGING INTERVALS

0 22 clay

22 32 shale

32 35 lime

35 56 shale

56 70 lime + shale

70 90 lime