


1] LOCATION OF WATER WELL:	Fraction	Section Number	Township Number	Range Number
County: <u>Butler</u>	<u>C 1/4 SW 1/4 SW 1/4</u>	<u>18</u>	<u>T 27S S</u>	<u>R 3E EW</u>

Distance and direction from nearest town or city street address of well if located within city?

1608 Highlander, Andover2] WATER WELL OWNER Rich SpurlinRR#, St. Address, Box # : 1608 Highlander  
City, State, ZIP Code : Andover, KS 67002Board of Agriculture, Division of Water Resources  
Application Number:3] LOCATE WELL'S LOCATION WITH 4] DEPTH OF COMPLETED WELL 98' ft. ELEVATION:

AN "X" IN SECTION BOX:

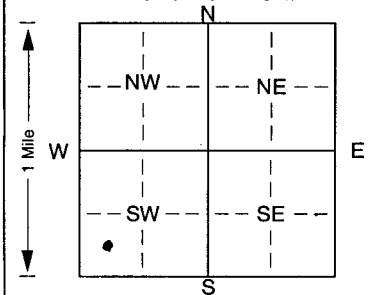

Depth(s) Groundwater Encountered 1. .... ft. 2. .... ft. 3. .... ft.

WELL'S STATIC WATER LEVEL 30 ft. below land surface measured on mo/day/yr 2-28-02

Pump test data: Well water was .... ft. after .... hours pumping .... gpm

Est. Yield .... gpm: Well water was .... ft. after .... hours pumping .... gpm

Bore Hole Diameter. 9 in. to 98' ft., and .... in. to .... ft.

WELL WATER TO BE USED AS: 5 Public water supply 8 Air conditioning 11 Injection well

1 Domestic 3 Feedlot 6 Oil field water supply 9 Dewatering 12 Other (Specify below)

2 Irrigation 4 Industrial 7 Domestic (lawn & garden) 10 Monitoring wellWas a chemical/bacteriological sample submitted to Department? Yes. .... No. X; If yes, mo/day/yr sample was submittedWater Well Disinfected? Yes X No5] TYPE OF BLANK CASING USED: 5 Wrought iron 8 Concrete tile CASING JOINTS: Glued. X Clamped. ....

1 Steel 3 RMP (SR) 6 Asbestos-Cement 9 Other (specify below) Welded. ....

2 PVC 4 ABS 7 Fiberglass .... Threaded. ....Blank casing diameter .... 5 in. to 58' ft., Dia .... in. to .... ft., Dia .... in. to .... ft.Casing height above land surface. .... 12 in., weight .... lbs./ft. Wall thickness or gauge No. SDR 26TYPE OF SCREEN OR PERFORATION MATERIAL: 7 PVC 10 Asbestos-cement

1 Steel 3 Stainless steel 5 Fiberglass 8 RMP (SR) 11 Other (specify) ....

2 Brass 4 Galvanized steel 6 Concrete tile 9 ABS 12 None used (open hole)

SCREEN OR PERFORATION OPENINGS ARE: 5 Gauzed wrapped 8 Saw cut 11 None (open hole)

1 Continuous slot 3 Mill slot 6 Wire wrapped 9 Drilled holes

2 Louvered shutter 4 Key punched 7 Torch cut 10 Other (specify) .... ft.

SCREEN-PERFORATED INTERVALS: From 58 ft. to 98 ft., From .... ft. to .... ft.

From .... ft. to .... ft., From .... ft. to .... ft.

GRAVEL PACK INTERVALS: From 20 ft. to 98 ft., From .... ft. to .... ft.

From .... ft. to .... ft., From .... ft. to .... ft.

6] GROUT MATERIAL: 1 Neat cement 2 Cement grout 3 Bentonite 4 Other

Grout Intervals: From 4 ft. to 20 ft., From .... ft. to .... ft., From .... ft. to .... ft.

What is the nearest source of possible contamination: 10 Livestock pens 14 Abandoned water well

1 Septic tank 4 Lateral lines 7 Pit privy 11 Fuel storage 15 Oil well/Gas well

2 Sewer lines 5 Cess pool 8 Sewage lagoon 12 Fertilizer storage 16 Other (specify below)

3 Watertight sewer lines 6 Seepage pit 9 Feedyard 13 Insecticide storage

Direction from well? How many feet?

FROM TO LITHOLOGIC LOG FROM TO PLUGGING INTERVALS

0 23 clay

23 35 shale

35 38 lime

38 62 shale

62 84 lime w/ shale str

84 98 lime + dirty lime

7] CONTRACTOR'S OR LANDOWNER'S CERTIFICATION: This water well was (1) constructed, (2) reconstructed, or (3) plugged under my jurisdiction and wascompleted on (mo/day/year) 2-28-02 and this record is true to the best of my knowledge and belief. KansasWater Well Contractor's Licence No. 171 This Water Well Record was completed on (mo/day/yr) 3-13-02under the business name of G + S Drilling, Inc. by (signature) [Signature]