

1	LOCATION OF WATER WELL:	Fraction	Section Number	Township Number	Range Number
	County: <u>Butler</u>	<u>SE</u> $\frac{1}{4}$ <u>SE</u> $\frac{1}{4}$ <u>NW</u> $\frac{1}{4}$	<u>18</u>	T <u>27</u> S	R <u>3</u> <u>E/W</u>

Distance and direction from nearest town or city street address of well if located within city?

902 TERRADINE ANDOVER KS. 67002


2	WATER WELL OWNER: JAY EWY
---	---------------------------

RR#, St. Address, Box # : 6514 WARREN Wichita KS. 67212  
City, State, ZIP Code :

Board of Agriculture, Division of Water Resources  
Application Number:

3	LOCATE WELL'S LOCATION WITH AN "X" IN SECTION BOX:
---	--

4 DEPTH OF COMPLETED WELL ..... 93 ..... ft. ELEVATION:

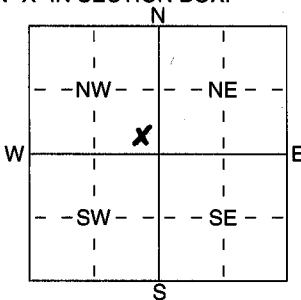

Depth(s) Groundwater Encountered 1 4.8 ft. 2 \_\_\_\_\_ ft. 3 \_\_\_\_\_ ft.  
WELL'S STATIC WATER LEVEL 4.8 ft. below land surface measured on mo/day/yr 2-5-03  
Pump test data: Well water was \_\_\_\_\_ ft. after \_\_\_\_\_ hours pumping \_\_\_\_\_ gpm  
Est. Yield MARGINAL gpm Well water was \_\_\_\_\_ ft. after \_\_\_\_\_ hours pumping \_\_\_\_\_ gpm  
WELL WATER TO BE USED AS: 5 Public water supply 8 Air conditioning 11 Injection well  
1 Domestic 3 Feedlot 6 Oil field water supply 9 Dewatering 12 Other (Specify below)  
2 Irrigation 4 Industrial 7 Domestic (lawn & garden) 10 Monitoring well \_\_\_\_\_ Heating

Was a chemical/bacteriological sample submitted to Department? Yes ..... No .....  
 If yes, mo/day/lys sample was submitted  
 Water Well Disinfected? Yes ..... No .....

5	TYPE OF BLANK CASING USED:
---	----------------------------

## 5 Wrought iron

8 Concrete tile

CASING JOINTS: Glued ...~~X~~..... Clamped .....

1 Steel  
2 PVC  
3 RMP (SR)  
4 ABS

6 Asbestos-Cement  
7 Fiberglass

9 Other (specify below)

Welded .....

Blank casing diameter ..... 5 ..... in. to ..... 23 ..... ft., Dia ..... in. to ..... ft., Dia ..... in. to ..... ft.

Casing height above land surface ..... 18 ..... in., weight ..... 50R26 ..... lbs./ft. Wall thickness or gauge No. ....

TYPE OF SCREEN OR PERFORATION MATERIAL:

1 Steel                      3 Stainless Steel                      5 Fiberglass                      7 RMP (SR)                      9 Other (Specify) .....

2 Brass                      4 Galvanized Steel                      6 Concrete tile                      8 ABS                      10 None used (open hole)

SCREEN OR PERFORATION OPENINGS ARE:

1 Continuous slot      3 Mill slot      6 Wire wrapped      9 Drilled holes  
2 Louvered shutter      4 Key punched      7 Torch cut      10 Other (specify) .....ft.

SCREEN-PERFORATED INTERVALS: From 73 ft. to 93 ft., From \_\_\_\_\_ ft. to \_\_\_\_\_ ft.

GRAVEL PACK INTERVALS: From 24 ft. to 93 ft., From \_\_\_\_\_ ft. to \_\_\_\_\_ ft.

6	GROUT MATERIAL:	1 Neat cement	2 Cement grout	3 Bentonite	4 Other .....
---	-----------------	---------------	----------------	-------------	---------------

Grout Intervals: From 2 ft. to 24 ft., From \_\_\_\_\_ ft. to \_\_\_\_\_ ft., From \_\_\_\_\_ ft. to \_\_\_\_\_ ft.

What is the nearest source of possible contamination:

1 Septic tank	4 Lateral lines	7 Pit privy	11 Fuel storage	15 Oil well/Gas well
2 Sewer lines	5 Cess pool	8 Sewage lagoon	12 Fertilizer storage	16 Other (specify below)
3 Watertight sewer lines	6 Seepage pit	9 Feedyard	13 Insecticide storage	<i>Water Drain</i>

Direction from well? W How many feet? 120

[illegible]

7 CONTRACTOR'S OR LANDOWNER'S CERTIFICATION: This water well was 1 constructed, (2) reconstructed, or (3) plugged under my jurisdiction and was completed on (mo/day/year) 2-5-03 and this record is true to the best of my knowledge and belief. Kansas Water Well Contractor's Licence No 464 This Water Well Record was completed on (mo/day/yr) 2-14-03 under the business name of WATER WELL SERVICES by (signature) [Signature]