

WATER WELL RECORD Form WWC-5 KSA 82a-1212 ID No.

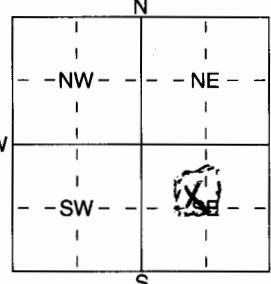
1 LOCATION OF WATER WELL:	Fraction County: Butler NW $\frac{1}{4}$ NW $\frac{1}{4}$ SE $\frac{1}{4}$	Section Number 17	Township Number T 27 R 30	Range Number E 30
---------------------------	---	----------------------	------------------------------	----------------------

Distance and direction from nearest town or city street address of well if located within city?

TreeScope

Anderson, KS

2 WATER WELL OWNER:

RR#, St. Address, Box #: 704 E woodstone ct 80
City, State, ZIP CodeBoard of Agriculture, Division of Water Resources
Application Number:3 LOCATE WELL'S LOCATION WITH
AN "X" IN SECTION BOX:

4 DEPTH OF COMPLETED WELL ft. ELEVATION:

Depth(s) Groundwater Encountered 25 ft. 2 ft. 3 ft.

WELL'S STATIC WATER LEVEL 25 ft. below land surface measured on mo/day/yr 11-08-04

Pump test data: Well water was ft. after hours pumping gpm

Est. Yield 25 gpm: Well water was ft. after hours pumping gpm

WELL WATER TO BE USED AS: 5 Public water supply 8 Air conditioning 11 Injection well

1 Domestic 3 Feedlot 6 Oil field water supply 9 Dewatering 12 Other (Specify below)

2 Irrigation 4 Industrial 0 Domestic (lawn & garden) 10 Monitoring well

Was a chemical/bacteriological sample submitted to Department? Yes No ; If yes, mo/day/yr sample was submittedWater Well Disinfected? Yes No

5 TYPE OF BLANK CASING USED:

1 Steel 3 RMP (SR)
PVC 4 ABS5 Wrought iron 8 Concrete tile
6 Asbestos-Cement 9 Other (specify below)
7 FiberglassCASING JOINTS: Glued Clamped
Welded
Threaded

Blank casing diameter in. to ft., Dia in. to ft., Dia in. to ft.

Casing height above land surface in., weight lbs./ft. Wall thickness or guage No.

TYPE OF SCREEN OR PERFORATION MATERIAL:

1 Steel 3 Stainless Steel
2 Brass 4 Galvanized Steel5 Fiberglass 8 RMP (SR)
6 Concrete tile 9 ABS10 Asbestos-Cement
11 Other (Specify)
12 None used (open hole)

SCREEN OR PERFORATION OPENINGS ARE:

1 Continuous slot Mill slot
2 Louvered shutter 4 Key punched5 Guazed wrapped 8 Saw cut 11 None (open hole)
6 Wire wrapped 9 Drilled holes
7 Torch cut 10 Other (specify) ft.

SCREEN-PERFORATED INTERVALS: From 20 ft. to 80 ft., From ft. to ft.

From ft. to ft., From ft. to ft.

GRAVEL PACK INTERVALS: From 25 ft. to 80 ft., From ft. to ft.
From ft. to ft., From ft. to ft.

6 GROUT MATERIAL: 1 Neat cement 2 Cement grout 3 Bentonite 4 Other

Grout Intervals: From 3 ft. to 25 ft., From ft. to ft., From ft. to ft.

What is the nearest source of possible contamination:

1 Septic tank 4 Lateral lines 7 Pit privy 10 Livestock pens 14 Abandoned water well
2 Sewer lines 5 Cess pool 8 Sewage lagoon 11 Fuel storage 15 Oil well/Gas well
3 Watertight sewer lines 6 Seepage pit 9 Feedyard 12 Fertilizer storage 16 Other (specify below)

Direction from well? East How many feet? 45

FROM TO LITHOLOGIC LOG FROM TO PLUGGING INTERVALS

0 1 Top soil

1 3 Clay

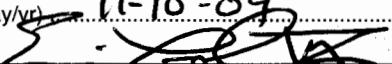
3 23 Limestone

23 80 Shale

RECEIVED

DEC 03 2004

BUREAU OF WATER

7 CONTRACTOR'S OR LANDOWNER'S CERTIFICATION: This water well was (1) constructed, (2) reconstructed, or (3) plugged under my jurisdiction and was completed on (mo/day/year) 11-08-04 and this record is true to the best of my knowledge and belief. KansasWater Well Contractor's Licence No. 318 This Water Well Record was completed on (mo/day/year) 11-10-04
under the business name of Weninger Drilling Inc. by (signature) 

INSTRUCTIONS: Use typewriter or ball point pen. PLEASE PRESS FIRMLY and PRINT clearly. Please fill in blanks, underline or circle the correct answers. Send top three copies to Kansas Department of Health and Environment, Bureau of Water, Geology Section, 1000 SW Jackson St., Suite 420, Topeka, Kansas 66612-1367. Telephone 785-296-5522. Send one to WATER WELL OWNER and retain one for your records. Fee of \$5.00 for each constructed well.