
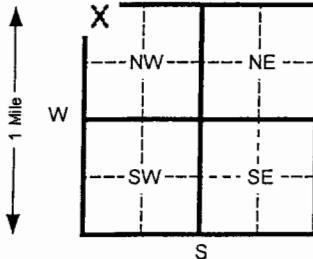


1 LOCATION OF WATER WELL:			Fraction	Section Number	Township Number	Range Number
County: Butler			NW $\frac{1}{4}$ NW $\frac{1}{4}$ NW $\frac{1}{4}$	29	T 27S S	R X 3
Distance and direction from nearest town or city street address of well if located within city? 514 South Andover Rd, Andover, KS, Lat.: 37°40'44.83538" Long.: 97°8'4.66854"						
2 WATER WELL OWNER: Phillips 66 Company						
RR#, St. Address, Box # : 1234 Phillips 66 Bldg.			Board of Agriculture, Division of Water Resources			
City, State, ZIP Code : Bartlesville, OK 74004			Application Number:			
3 LOCATE WELL'S LOCATON WITH AN "X" IN SECTION BOX:			4 DEPTH OF COMPLETED WELL 18 ft. ELEVATION: 1321.68 (TOC)			
			Depth(s) Groundwater Encountered 1 11 ft. 2 ft. 3 9/28/05 ft. WELL'S STATIC WATER LEVEL 11.3 ft. below land surface measured on mo/day/yr Pump test data: Well water was N/A ft. after hours pumping gpm Est. Yield N/A gpm: Well water was N/A ft. after hours pumping gpm Bore Hole Diameter 8 in. to 18 ft. and in. to ft. WELL WATER TO BE USED AS: 5 Public water supply 8 Air conditioning 11 Injection well 1 Domestic 3 Feed lot 6 Oil field water supply 9 Dewatering 12 Other (Specify below) 2 Irrigation 4 Industrial 7 Lawn and garden (domestic) 10 Monitoring well			
Was a chemical/bacteriological sample submitted to Department? Yes No X If yes, mo/day/yr sample was submitted Water Well Disinfected? Yes No X						
5 TYPE OF BLANK CASING USED:						
1 Steel		3 RMP (SR)		5 Wrought Iron		CASING JOINTS: Glued _____ Clamped _____
2 PVC		4 ABS		6 Asbestos-Cement		Welded _____ Threaded _____
Blank casing diameter 2 in. to 8 ft., Dia		in. to 0 in., weight 0.682		in. to ft., Dia		in. to ft.
Casing height above land surface 0 lbs./ft. Wall thickness or gauge No. 0.154 in.						
TYPE OF SCREEN OR PERFORATION MATERIAL:						
1 Steel		3 Stainless steel		5 Fiberglass		7 PVC 10 Asbestos-cement
2 Brass		4 Galvanized steel		6 Concrete tile		8 RMP (SR) 11 Other (specify) 9 ABS 12 None used (open hole)
SCREEN OR PERFORATION OPENINGS ARE:						
1 Continuous slot		3 Mill slot		5 Gauzed wrapped		8 Saw cut 11 None (open hole)
2 Louvered shutter		4 Key punched		6 Wire wrapped		9 Drilled holes
SCREEN-PERFORATED INTERVALS:		From 8 ft. to 18 ft.		From		ft. to ft.
GRAVEL PACK INTERVALS:		From 6 ft. to 18 ft.		From		ft. to ft.
6 GROUT MATERIAL: 1 Neat cement 2 Cement grout 3 Bentonite 4 Other						
Grout Intervals From 1 ft. to 6 ft.		From		ft. to ft.		From ft. to ft.
What is the nearest source of possible contamination:						
1 Septic tank		4 Lateral lines		7 Pit privy		10 Livestock pens 14 Abandoned water well
2 Sewer lines		5 Cess pool		8 Sewage lagoon		11 Fuel storage 15 Oil well/ Gas well
3 Watertight sewer lines		6 Seepage pit		9 Feedyard		12 Fertilizer storage 16 Other (specify below) 13 Insecticide storage
Direction from well? Unknown How many feet? Unknown						
FROM TO CODE LITHOLOGIC LOG FROM TO PLUGGING INTERVALS						
0	.8	Concrete				
.8	2.0	Concrete fill material				
2.0	11.0	Clay and Silt				
11.0	18.0	Clayey Sand				
RECEIVED						
NOV 18 2005						
BUREAU OF WATER						
7 CONTRACTOR'S OR LANDOWNER'S CERTIFICATION: This water well was (1) constructed, (2) reconstructed, or (3) plugged under my jurisdiction and was completed on (mo/day/yr) 09/26/05 and this record is true to the best of my knowledge and belief. Kansas Water Well Contractor's License No. 616 This Water Well Record was completed on (mo/day/yr) 10/10/05 under the business name of Thiele Geotech, Inc. by (signature) D. J. A.						
INSTRUCTIONS.. Please fill in blanks and circle the correct answers. Send three copies to Kansas Department of Health and Environment, Bureau of Water, 1000 S W Jackson St., Ste. 420, Topeka, Kansas 66612-1367. Telephone: 913-296-5545. Send one to WATER WELL OWNER and retain one for your records.						

US HIGHWAY 54 (WEST BOUND)

US HIGHWAY 54 (EAST BOUND)

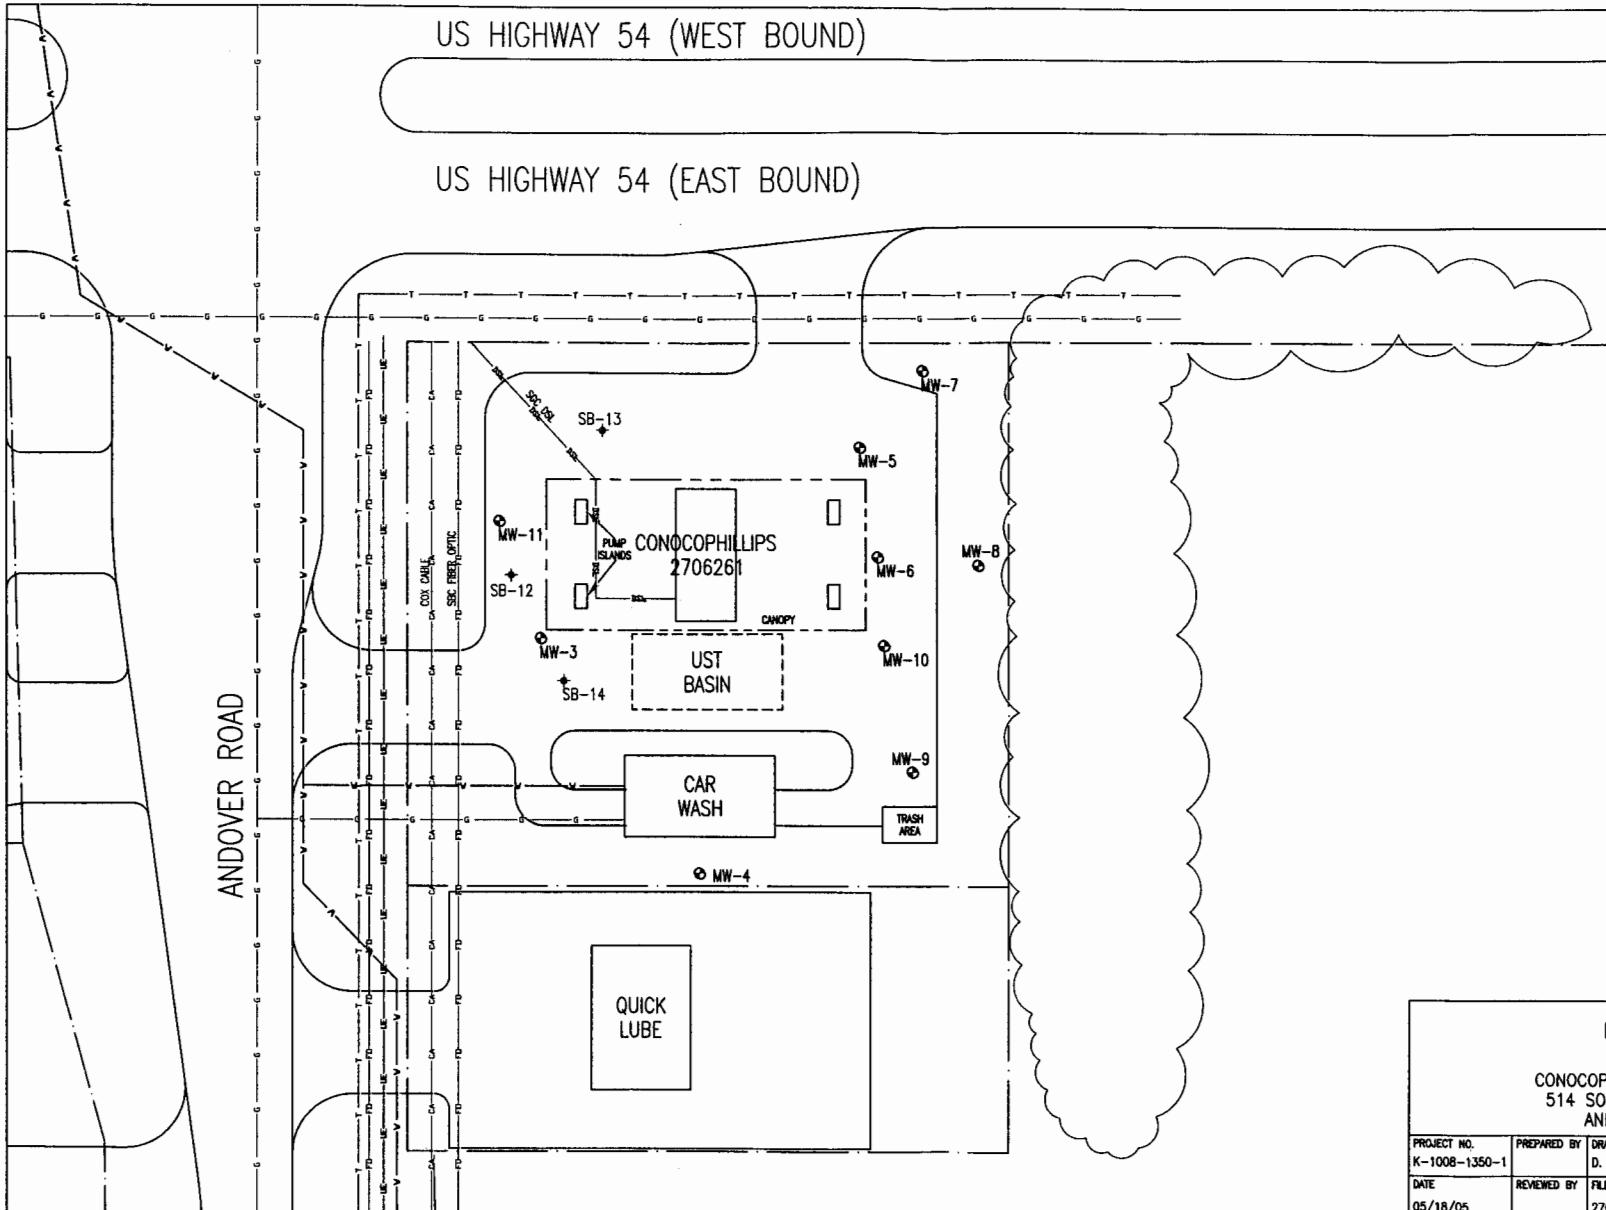

LEGEND

SB-	SOIL BORING LOCATION
MW-	MONITORING WELL LOCATION
OE	OVERHEAD ELECTRIC
UE	UNDERGROUND ELECTRIC
T	TELEPHONE LINE
FO	FIBER OPTICS
W	WATER LINE
G	GAS LINE
CA	CABLE LINE
DSL	DSL LINE
	PROPERTY BOUNDARY



FIGURE 2
SITE MAP

CONOCOPHILLIPS NO. 2706261
514 SOUTH ANDOVER ROAD
ANDOVER, KANSAS

PROJECT NO. K-1008-1350-1	PREPARED BY D. Reeder	DRAWN BY D. Reeder
DATE 05/18/05	REVIEWED BY	FILE NAME 2706261am40-1ei