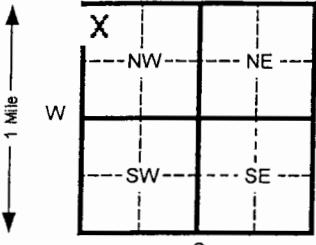
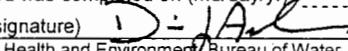


|  |      |                    |   |                   |                 |                                       |                          |          |
|--|------|--------------------|---|-------------------|-----------------|---------------------------------------|--------------------------|----------|
| 1 LOCATION OF WATER WELL:  |      |                    | Fraction  | Section Number    | Township Number | Range Number                          |                          |          |
| County: Butler   |      |                    | NW $\frac{1}{4}$ NW $\frac{1}{4}$ NW $\frac{1}{4}$  | 29                | T 27 S          | R X 3                                 |                          |          |
| Distance and direction from nearest town or city street address of well if located within city?<br>514 South Andover Rd, Andover, KS, Lat.: 37°40'43.86609" Long.: 97°8'4.41107"   |      |                    |   |                   |                 |                                       |                          |          |
| 2 WATER WELL OWNER: Phillips 66 Company  |      |                    | Board of Agriculture, Division of Water Resources Application Number:   |                   |                 |                                       |                          |          |
| RR#, St. Address, Box # : 1234 Phillips 66 Bldg.   |      |                    |   |                   |                 |                                       |                          |          |
| City, State, ZIP Code : Bartlesville, OK 74004   |      |                    |   |                   |                 |                                       |                          |          |
| 3 LOCATE WELL'S LOCATON WITH AN "X" IN SECTION BOX:  |      |                    | 4 DEPTH OF COMPLETED WELL   |                   |                 |                                       |                          |          |
|    |      |                    | Depth(s) Groundwater Encountered 1 14 ft. ELEVATION: 20 ft. 1322.15 (TOC)<br>WELL'S STATIC WATER LEVEL 19.08 ft. below land surface measured on mo/day/yr 9/28/05<br>Pump test data: Well water was N/A ft. after hours pumping gpm<br>Est. Yield N/A gpm: Well water was N/A ft. after hours pumping gpm<br>Bore Hole Diameter 8 in. to 20 ft. and in. to ft.<br>WELL WATER TO BE USED AS: 5 Public water supply 8 Air conditioning 11 Injection well<br>1 Domestic 3 Feed lot 6 Oil field water supply 9 Dewatering 12 Other (Specify below)<br>2 Irrigation 4 Industrial 7 Lawn and garden (domestic) 10 Monitoring well<br>Was a chemical/bacteriological sample submitted to Department? Yes No X If yes, mo/day/yr sample was submitted<br>Water Well Disinfected? Yes No X |                   |                 |                                       |                          |          |
| 5 TYPE OF BLANK CASING USED:   |      |                    |   |                   |                 |                                       |                          |          |
| 1 Steel  |      | 3 RMP (SR)         |   | 5 Wrought Iron    |                 | 8 Concrete tile                       | CASING JOINTS: Glued     | Clamped  |
| 2 PVC  |      | 4 ABS              |   | 6 Asbestos-Cement |                 | 9 Other (specify below)               | Welded                   | Threaded |
| Blank casing diameter 2 in. to   |      | 5 ft., Dia         |   | in. to            |                 | ft., Dia                              | in. to                   | ft.      |
| Casing height above land surface 0 in., weight   |      | 0.682              |   | lbs./ft.          |                 | Wall thickness or gauge No. 0.154 in. |                          |          |
| TYPE OF SCREEN OR PERFORATION MATERIAL:  |      |                    |   |                   |                 |                                       |                          |          |
| 1 Steel  |      | 3 Stainless steel  |   | 5 Fiberglass      |                 | 7 PVC                                 | 10 Asbestos-cement       |          |
| 2 Brass  |      | 4 Galvanized steel |   | 6 Concrete tile   |                 | 8 RMP (SR)                            | 11 Other (specify)       |          |
| SCREEN OR PERFORATION OPENINGS ARE:  |      | 1 Continuous slot  |   | 3 Mill slot       |                 | 9 ABS                                 | 12 None used (open hole) |          |
| 2 Louvered shutter   |      | 4 Key punched      |   | 5 Gauzed wrapped  |                 | 8 Saw cut                             | 11 None (open hole)      |          |
| SCREEN-PERFORATED INTERVALS:   |      | From 5 ft. to 20   |   | ft. From          |                 | 9 Drilled holes                       | 10 Other (specify)       |          |
| GRAVEL PACK INTERVALS:   |      | From 3 ft. to 20   |   | ft. From          |                 | ft. to                                | ft. to                   |          |
| From   |      | ft. to             |   | ft. From          |                 | ft. to                                | ft. to                   |          |
| 6 GROUT MATERIAL: 1 Neat cement 2 Cement grout 3 Bentonite 4 Other   |      |                    |   |                   |                 |                                       |                          |          |
| Grout Intervals From 1 ft. to 3 ft. From   |      | ft. to             |   | ft. From          |                 | ft. to                                | ft. to                   | ft.      |
| What is the nearest source of possible contamination:  |      |                    |   |                   |                 |                                       |                          |          |
| 1 Septic tank  |      | 4 Lateral lines    |   | 7 Pit privy       |                 | 10 Livestock pens                     | 14 Abandoned water well  |          |
| 2 Sewer lines  |      | 5 Cess pool        |   | 8 Sewage lagoon   |                 | 11 Fuel storage                       | 15 Oil well/ Gas well    |          |
| 3 Watertight sewer lines   |      | 6 Seepage pit      |   | 9 Feedyard        |                 | 12 Fertilizer storage                 | 16 Other (specify below) |          |
| 13 Insecticide storage   |      |                    |   |                   |                 |                                       |                          |          |
| Direction from well? Unknown How many feet? Unknown  |      |                    |   |                   |                 |                                       |                          |          |
| FROM   | TO   | CODE               | LITHOLOGIC LOG  |                   | FROM            | TO                                    | PLUGGING INTERVALS       |          |
| 0  | 0.6  |                    | Concrete  |                   |                 |                                       |                          |          |
| 0.5  | 1.0  |                    | Concrete fill material  |                   |                 |                                       |                          |          |
| 1.0  | 8.5  |                    | Clay and Silt   |                   |                 |                                       |                          |          |
| 8.5  | 12.0 |                    | Clayey Sand   |                   |                 |                                       |                          |          |
| 12.0   | 20.0 |                    | Clay and Silt   |                   |                 |                                       |                          |          |
|  |      |                    |   |                   |                 |                                       | RECEIVED                 |          |
|  |      |                    |   |                   |                 |                                       | NOV 18 2005              |          |
|  |      |                    |   |                   |                 |                                       | BUREAU OF WATER          |          |
| 7 CONTRACTOR'S OR LANDOWNER'S CERTIFICATION: This water well was (1) constructed, (2) reconstructed, or (3) plugged under my jurisdiction and was completed on (mo/day/yr) 09/26/05 and this record is true to the best of my knowledge and belief. Kansas   |      |                    |   |                   |                 |                                       |                          |          |
| Water Well Contractor's License No. 616 This Water Well Record was completed on (mo/day/yr) 10/10/05   |      |                    |   |                   |                 |                                       |                          |          |
| under the business name of Thiele Geotech, Inc. by (signature)    |      |                    |   |                   |                 |                                       |                          |          |
| INSTRUCTIONS: Please fill in blanks and circle the correct answers. Send three copies to Kansas Department of Health and Environment Bureau of Water, 1000 S W Jackson St, Ste. 420, Topeka, Kansas 66612-1367. Telephone: 913-296-5545. Send one to WATER WELL OWNER and retain one for your records. |      |                    |   |                   |                 |                                       |                          |          |

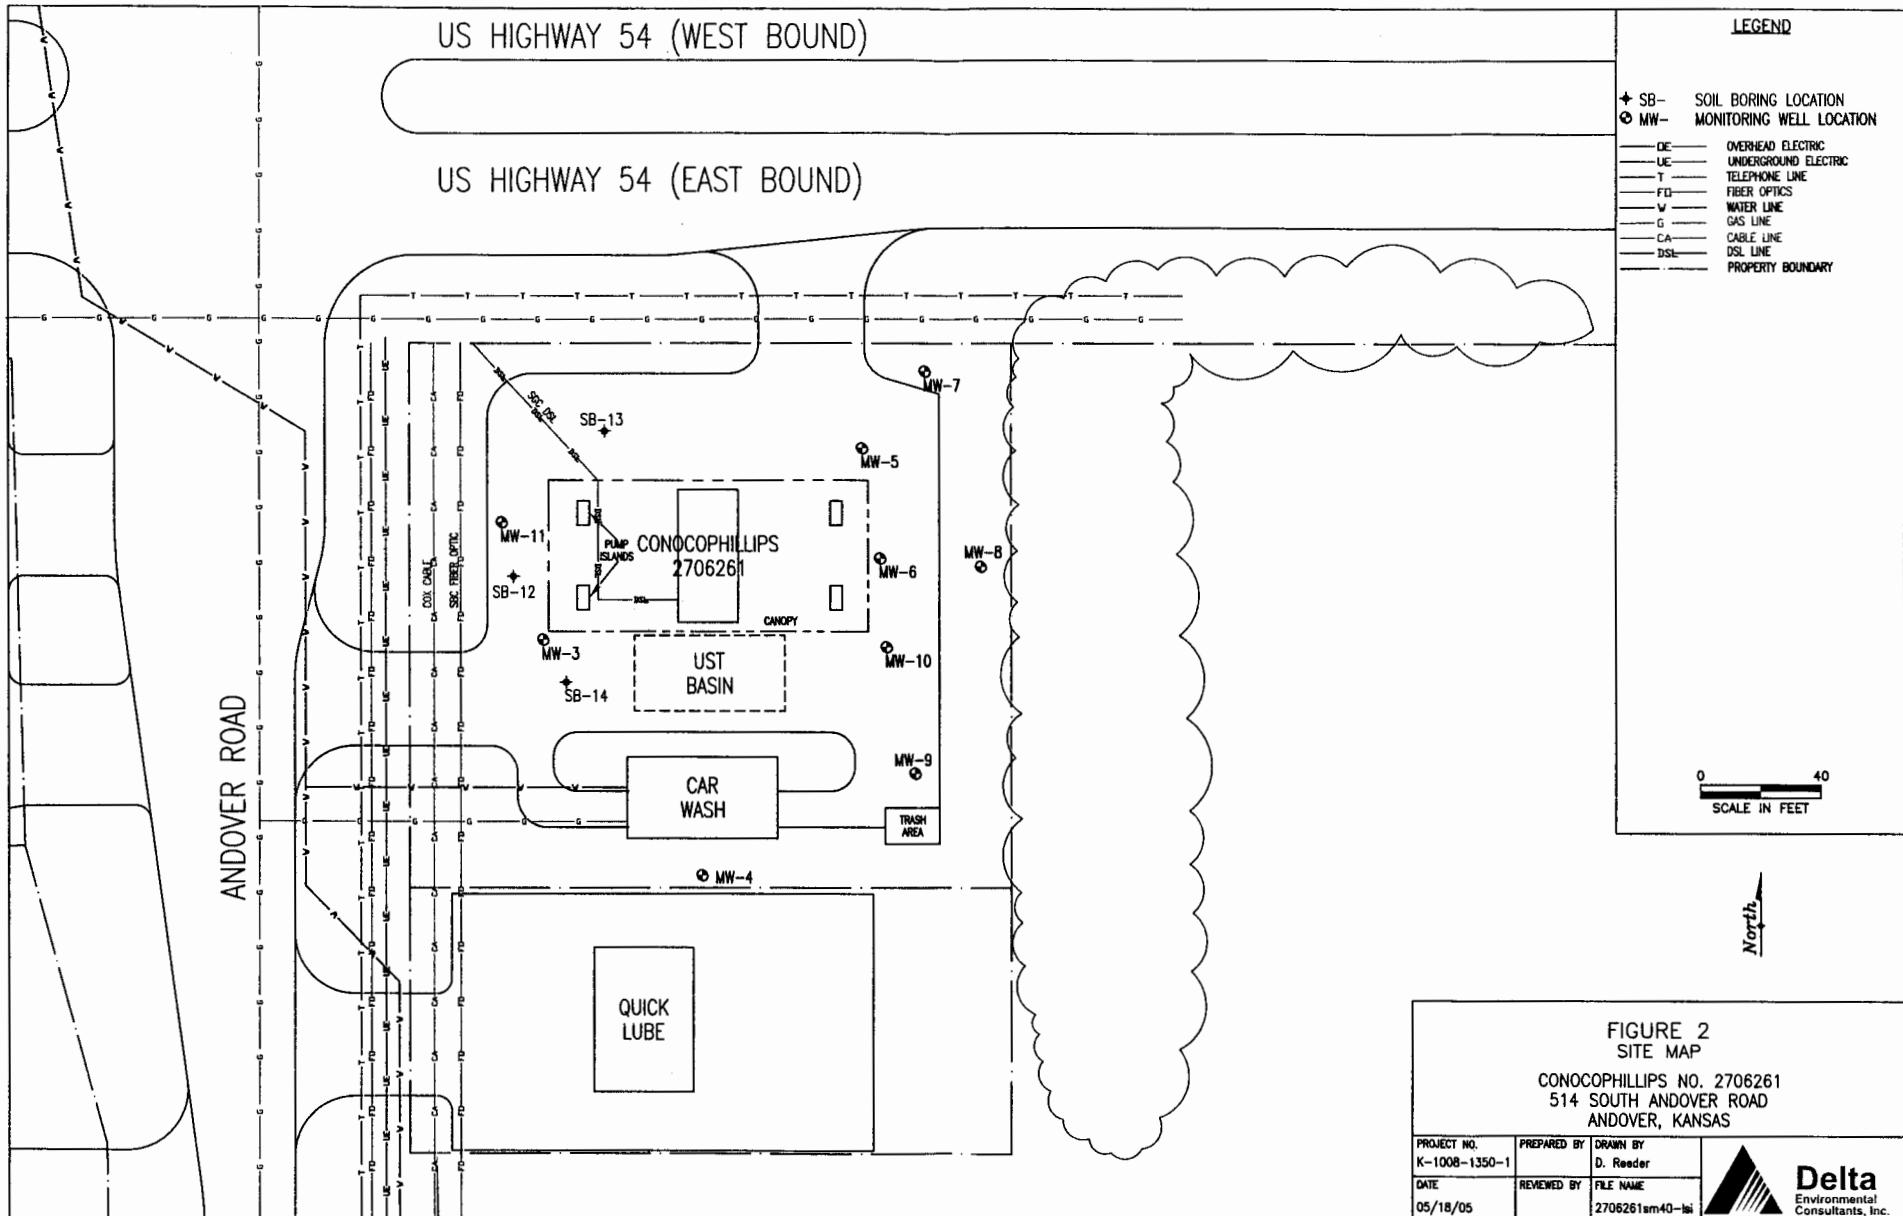


FIGURE 2  
SITE MAP

CONOCOPHILLIPS NO. 2706261  
514 SOUTH ANDOVER ROAD  
ANDOVER, KANSAS

|                              |                          |                              |
|------------------------------|--------------------------|------------------------------|
| PROJECT NO.<br>K-1008-1350-1 | PREPARED BY<br>D. Reeder | DRAWN BY<br>D. Reeder        |
| DATE<br>05/18/05             | REVIEWED BY              | FILE NAME<br>2706261sm40-lai |

**Delta**  
Environmental  
Consultants, Inc.