

1 LOCATION OF WATER WELL: County: <u>Butler</u>	Fraction <u>NE</u> $\frac{1}{4}$ <u>NW</u> $\frac{1}{4}$ <u>NE</u> $\frac{1}{4}$	Section Number <u>7</u>	Township Number T <u>27</u> S	Range Number R <u>3</u> E <u>XX</u>
--	---	----------------------------	----------------------------------	--


Distance and direction from nearest town or city street address of well if located within city?

542 W. Grace, Andover, KS 67002

2 WATER WELL OWNER: Byron West
RR#, St. Address, Box # : 542 W. Grace
City, State, ZIP Code : Andover, KS 67002

Board of Agriculture, Division of Water Resources
Application Number:

3 LOCATE WELL'S LOCATION WITH AN "X" IN SECTION BOX. 4 DEPTH OF COMPLETED WELL. 90 ft. ELEVATION:

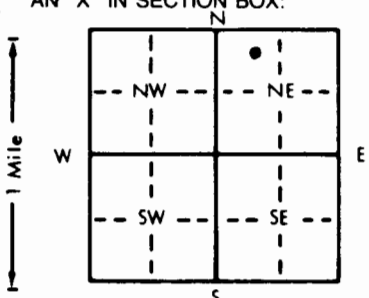

Depth(s) Groundwater Encountered 1. ft. 2. ft. 3. ft.
WELL'S STATIC WATER LEVEL 18 ft. below land surface measured on mo/day/yr 7/6/98
Pump test data: Well water was ft. after hours pumping gpm
Est. Yield gpm: Well water was ft. after hours pumping gpm
Bore Hole Diameter 9 in. to 90 ft., and in. to ft.
WELL WATER TO BE USED AS: 5 Public water supply 8 Air conditioning 11 Injection well
1 Domestic 3 Feedlot 6 Oil field water supply 9 Dewatering 12 Other (Specify below)
2 Irrigation 4 Industrial ☒ Lawn and garden only 10 Monitoring well
Was a chemical/bacteriological sample submitted to Department? Yes.....No.....X; If yes, mo/day/yr sample was submitted
Water Well Disinfected? Yes.....Y.....No.....

5 TYPE OF BLANK CASING USED:		5 Wrought iron	8 Concrete tile	CASING JOINTS: Glued <input checked="" type="checkbox"/> . . . Clamped
1 Steel	3 RMP (SR)	6 Asbestos-Cement	9 Other (specify below)	Welded
<input checked="" type="checkbox"/> PVC	4 ABS	7 Fiberglass		Threaded
Blank casing diameter	5 . . . in. to . . . 50 . . . ft., Dia			
Casing height above land surface	12 . . . in., weight			lbs./ft. Wall thickness or gauge No. . . SDR26
TYPE OF SCREEN OR PERFORATION MATERIAL:				
1 Steel	3 Stainless steel	5 Fiberglass	<input checked="" type="checkbox"/> PVC	10 Asbestos-cement
2 Brass	4 Galvanized steel	6 Concrete tile	8 RMP (SR)	11 Other (specify)
			9 ABS	12 None used (open hole)
SCREEN OR PERFORATION OPENINGS ARE:				
1 Continuous slot	3 Mill slot	5 Gauzed wrapped	<input checked="" type="checkbox"/> Saw cut	11 None (open hole)
2 Louvered shutter	4 Key punched	6 Wire wrapped	9 Drilled holes	
		7 Torch cut	10 Other (specify)	
SCREEN-PERFORATED INTERVALS:				
	From 50 . . . ft. to . . . 90 . . . ft., From ft. to ft.			
	From ft. to ft., From ft. to ft.			
GRAVEL PACK INTERVALS:				
	From 20 . . . ft. to . . . 90 . . . ft., From ft. to ft.			
	From ft. to ft., From ft. to ft.			

6 GROUT MATERIAL:		1 Neat cement	2 Cement grout	3 Bentonite	4 Other
Grout Intervals:		From 4 ft. to 20 ft.	From	ft. to	ft. From
What is the nearest source of possible contamination:		10 Livestock pens 14 Abandoned water well 11 Fuel storage 15 Oil well/Gas well 12 Fertilizer storage 16 Other (specify below) 13 Insecticide storage			
Direction from well?		How many feet?			

[illegible]

7 CONTRACTOR'S OR LANDOWNER'S CERTIFICATION: This water well was (1) constructed, (2) reconstructed, or (3) plugged under my jurisdiction and was completed on (mo/day/year) 7/6/98 and this record is true to the best of my knowledge and belief. Kansas Water Well Contractor's License No. 171 This Water Well Record was completed on (mo/day/year) 7/17/98 under the business name of G & S Drilling, Inc. by (signature)