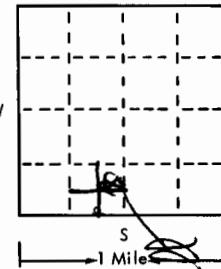
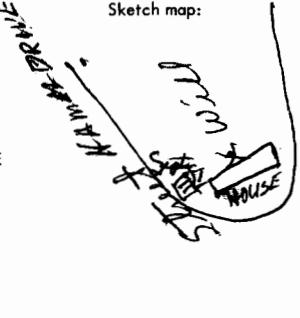


USE TYPEWRITER OR BALL
POINT PEN-PRESS FIRMLY,
PRINT CLEARLY.

WATER WELL RECORD
KSA 82a-1201-1215

T R EW sec 1/4 1/4 1/4 1/4

Kansas State Dept. of Health
(Water Well Contractors)
Forbes-Bldg. 740
Topeka, Kansas 66620

1 Location of well:	County BUTLER	Township name BRUNO	Fraction NE 1/4 SE 1/4 SW 1/4	Section number 29	Town number 275	Range number 3E
Distance and direction from nearest town or city: 3/4 MILE SO ANDOVER on ROSE HILL ROAD LAKEVIEW HEIGHTS ADD.				3 Owner of well: ZINN CONST CO 1440 COLLEN TERRACE WICHITA KANSAS		
Street address of well location if in city: 1110 Hamlin RD				Address:		
Locate with "X" in section below: 				Sketch map: 		
2	Type and color of material			From	To	
	Brown Surface Gravel			0	5	
	Yellow Clay			5	14	
	Limestone Rock			14	18	
	Light Gray Water Shale			17	19	
	Light Gray Clay			19	32	
16 Remarks: elevation	Customer known requirements on 4'X 4' Concrete Slab					
Topography:	<input type="checkbox"/> Hill <input checked="" type="checkbox"/> Slope <input type="checkbox"/> Upland <input type="checkbox"/> Valley			Customer known requirements on 4'X 4' Concrete Slab Neal P. Zinn		
17 Water well contractor's certification:	<p>This well was drilled under my jurisdiction and this report is true to the best of my knowledge and belief.</p> <p>SIMMONS DRILLING 162</p> <p>Business name 155 Central Andover Address 155 Central Andover Signed Ben Brumgar Date 11-15-75 Authorized representative Ben Brumgar</p>					

Forward the white, blue and pink copies to the Kansas State Dept. of Health.

Form WWC-5