

CORRECTION TO WATER WELL RECORD (WWC-5)

The following correction(s) was made to the attached WWC-5 log, in order to file the item or to rectify lacking or incorrect information.

Fraction (1/4 1/4 1/4) Section-Township-Range changed:

listed as 24 - 27S - 3E

changed to NE, SE, SE, 24-27S-3E

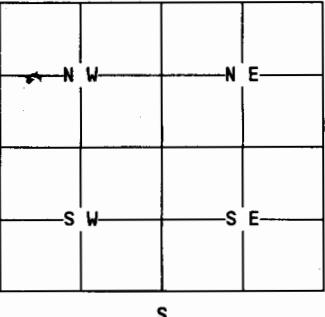
Other changes made:

Initial statements: _____

Comments:

~~Changed to:~~ Bosley's (well plugging contractor) house is at 9865 SW Santa Fe Lake Rd., Eldon Brand's property (where the well is located) is 2 houses North; 3 mi. W. of Augusta, KS then $\frac{1}{4}$ mi. N. on W. side of rd. Phone call to plugging contractor (316-775-1542), verificaton method: ~~Augusta & Santa Fe Lake, KS, 1:24,000~~ initials: ~~DRL~~ date: ~~1/29/99~~ topo maps

submitted by: Kansas Geological Survey, Data Resources Library, 1930 Constant Ave., Lawrence, KS 66047-3726
to: Kansas Dept of Health & Environment Bureau of Water Industrial Programs, Bldg 283, Forbes Field, KS 66620

1	LOCATION OF WATER WELL:	Fraction	Section Number	Township Number	Range Number																				
County: Butler		1/4 1/4 1/4	524	7275	R35																				
Distance and direction from nearest town or city street address of well if located within city?																									
2	WATER WELL OWNER: Eldon Brand	Board of Agriculture, Division of Water Resources Application Number:																							
RR#, St. Address, Box #: 9124 SW Eugene Rd		City, State, ZIP Code : Augusta, KS 67010																							
3	MARK WELL'S LOCATION WITH AN "X" IN SECTION BOX: N	4	DEPTH OF WELL..... <u>unknown</u> ft.	WELL'S STATIC WATER LEVEL <u>unknown</u> ft.																					
		WELL WAS USED AS: <table> <tr><td>1 Domestic</td><td>5 Public Water Supply</td><td>9 Dewatering</td></tr> <tr><td>2 Irrigation</td><td>6 Oil Field Water Supply</td><td>10 Monitoring Well</td></tr> <tr><td>3 Feedlot</td><td>7 Lawn and Garden Only</td><td>11 Injection Well</td></tr> <tr><td>4 Industrial</td><td>8 Air Conditioning</td><td>12 Other..... <i>Nothing</i> <i>Shut down 30 yrs ago</i></td></tr>
Was a chemical/bacteriological sample submitted to Department? Yes... <input checked="" type="checkbox"/> No... <input type="checkbox"/>																									
If yes, mo/day/yr sample was submitted.....																									
Water Well Disinfected: Yes. <input checked="" type="checkbox"/> No.....																									
5	TYPE OF BLANK CASING USED:																								
<input checked="" type="checkbox"/> 1 Steel <input type="checkbox"/> 3 RMP (SR) <input type="checkbox"/> 5 Wrought <input type="checkbox"/> 7 Fiberglass <input type="checkbox"/> 9 Other (specify below) <input type="checkbox"/> 2 PVC <input type="checkbox"/> 4 ABS <input type="checkbox"/> 6 Asbestos-Cement <input type="checkbox"/> 8 Concrete Tile																									
Blank casing diameter.....in. Was casing pulled? Yes... <input checked="" type="checkbox"/> No..... If yes, how much..... Casing height above or below land surface..... <i>5 1/4 ft below</i>																									
6	GROUT PLUG MATERIAL: 1 Neat cement <input checked="" type="checkbox"/> 2 Cement grout 3 Bentonite <input type="checkbox"/> 4 Other..... <i>1/2 ton gravel</i>																								
Grout Plug Intervals: From.....ft. to.....ft., From.....ft. toft., From..... to.....ft.																									
What is the nearest source of possible contamination:																									
<table> <tr><td>1 Septic tank</td><td>6 Seepage pit</td><td>11 Fuel storage</td><td>16 Other (specify below)</td></tr> <tr><td>2 Sewer lines</td><td>7 Pit privy</td><td>12 Fertilizer storage</td><td>.....</td></tr> <tr><td>3 Watertight sewer lines</td><td>8 Sewage lagoon</td><td>13 Insecticide storage</td><td>.....</td></tr> <tr><td>4 Lateral lines</td><td>9 Feedyard</td><td>14 Abandoned water well</td><td>.....</td></tr> <tr><td>5 Cess Pool</td><td>10 Livestock pens</td><td>15 Oil well/Gas well</td><td>.....</td></tr>
Direction from well? How many feet?																									
FROM	TO	PLUGGING MATERIALS																							
999	0	Gravel																							
6	3	Limestone																							
3	0	Clay																							
7	CONTRACTOR'S OR LANDOWNER'S CERTIFICATION: This water well was plugged under my jurisdiction and was completed on (mo/day/year)..... and this record is true to the best of my knowledge and belief. Kansas Water Well Contractor's license No. This Water Well Record was completed on (mo/day/year) by (signature)																								
INSTRUCTIONS: Use typewriter or ball point pen. Please press firmly and print clearly. Please fill in blanks, underline or circle the correct answers. Send top three copies to Kansas Department of Health and Environment, Bureau of Water, Topeka, Kansas 66620-0001. Telephone: 913/296-3565. Send one to Water Well Owner and retain one for your records.																									