

1 LOCATION OF WATER WELL:	Fraction County: <i>Butler</i>	<i>NW 1/4 NE 1/4 NW 1/4</i>	Section Number 19	Township Number T 27 S	Range Number R 3 E
---------------------------	-----------------------------------	-----------------------------	----------------------	---------------------------	-----------------------

Distance and direction from nearest town or city street address of well if located within city?


*IN City of Andover**Cindy Ball 921 S Andover Rd
Andover Kan 67002*Board of Agriculture, Division of Water Resources
Application Number:

2 WATER WELL OWNER:	Cindy Ball 921 S Andover Rd Andover Kan 67002				
---------------------	--	--	--	--	--

RR#, St. Address, Box # :

City, State, ZIP Code :

3 LOCATE WELL'S LOCATION WITH AN "X" IN SECTION BOX:

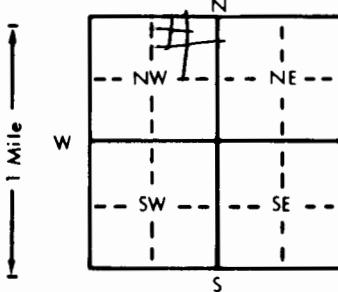

4 DEPTH OF COMPLETED WELL	110	ft. ELEVATION:			
---------------------------	-----	----------------	--	--	--

Depth(s) Groundwater Encountered 1. *85* ft. 2. ft. 3. ft.WELL'S STATIC WATER LEVEL *45* ft. below land surface measured on mo/day/yr

Pump test data: Well water was ft. after hours pumping gpm

Est. Yield *40* gpm Well water was ft. after hours pumping gpmBore Hole Diameter *7.5* in. to ft. and in. to ft.

WELL WATER TO BE USED AS: 5 Public water supply 8 Air conditioning 11 Injection well

1 Domestic 3 Feedlot 6 Oil field water supply 9 Dewatering 12 Other (Specify below)

2 Irrigation 4 Industrial *C* Lawn and garden only 10 Monitoring wellWas a chemical/bacteriological sample submitted to Department? Yes No If yes, mo/day/yr sample was submittedWater Well Disinfected? Yes No

5 TYPE OF BLANK CASING USED:	5 Wrought iron	8 Concrete tile	CASING JOINTS: Glued <input checked="" type="checkbox"/> Clamped <input type="checkbox"/>
------------------------------	----------------	-----------------	---

1 Steel 3 RMP (SR) 6 Asbestos-Cement 9 Other (specify below) Welded 2 PVC 4 ABS 7 Fiberglass Threaded Blank casing diameter *5* in. to *55* ft. Dia in. to ft. Dia in. to ft.Casing height above land surface *18* in. weight *160* lbs./ft. Wall thickness or gauge No. *214*

TYPE OF SCREEN OR PERFORATION MATERIAL:	<i>C</i> PVC	10 Asbestos-cement
---	--------------	--------------------

1 Steel 3 Stainless steel 5 Fiberglass 8 RMP (SR) 11 Other (specify) 2 Brass 4 Galvanized steel 6 Concrete tile 9 ABS 12 None used (open hole)

SCREEN OR PERFORATION OPENINGS ARE:	5 Gauzed wrapped	8 Saw cut	11 None (open hole)
-------------------------------------	------------------	-----------	---------------------

1 Continuous slot 3 Mill slot 6 Wire wrapped 9 Drilled holes 2 Louvered shutter 4 Key punched 7 Torch cut 10 Other (specify)

SCREEN-PERFORATED INTERVALS: From. <i>55</i>	ft. to <i>10</i>	ft., From. ft. to ft.
--	------------------	-----------------------

From. ft. to ft., From. ft. to ft.

GRAVEL PACK INTERVALS: From. ft. to ft.	ft., From. ft. to ft.
---	-----------------------

From. ft. to ft., From. ft. to ft.

6 GROUT MATERIAL: 1 Neat cement	2 Cement grout	3 Bentonite	4 Other
---------------------------------	----------------	-------------	---------

Grout Intervals: From. *3* ft. to *23* ft. From. ft. to ft., From. ft. to ft., From. ft. to ft.

What is the nearest source of possible contamination:

1 Septic tank 4 Lateral lines 7 Pit privy 10 Livestock pens 14 Abandoned water well

2 Sewer lines 5 Cess pool 8 Sewage lagoon 11 Fuel storage 15 Oil well/Gas well

3 Watertight sewer lines 6 Seepage pit 9 Feedyard 12 Fertilizer storage 16 Other (specify below) Direction from well? *N* How many feet? *150*

FROM	TO	LITHOLOGIC LOG	FROM	TO	PLUGGING INTERVALS
------	----	----------------	------	----	--------------------

0	4	<i>Sqit</i>			
---	---	-------------	--	--	--

4	20	<i>Clay</i>			
---	----	-------------	--	--	--

20	110	<i>Shale + lime</i>			
----	-----	---------------------	--	--	--

7 CONTRACTOR'S OR LANDOWNER'S CERTIFICATION: This water well was constructed, (2) reconstructed, or (3) plugged under my jurisdiction and was completed on (mo/day/year) *8/21/88* and this record is true to the best of my knowledge and belief. KansasWater Well Contractor's License No. *257* This Water Well Record was completed on (mo/day/year) *8/21/88* by (signature) *Charles Weston* under the business name of *Winterwell Drill*