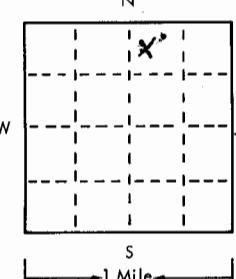
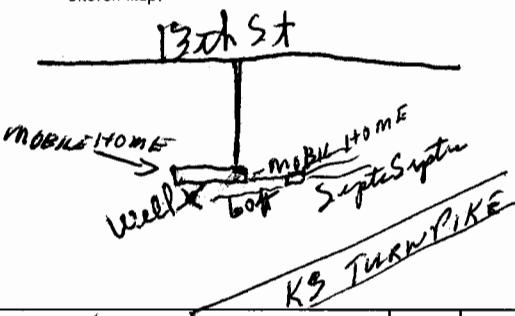


1 Location of well:	County <b>BUTLER</b>	Township name <b>BRUNO</b>	W Fraction <b>NE</b> <b>NW 1/4 SE 1/4</b>	Section number <b>18</b>	Town number <b>275</b>	Range number <b>3E</b>
Distance and direction from nearest town or city: <b>ANDOVER on 13th St</b>			3 Owner of well: <b>Virginia ROBINSON</b>			
Street address of well location if in city:			Address: <b>R 4 WICHITA KS</b>			
Locate with "X" in section below:  			Sketch map:  			
2	Type and color of material		From	To	4 Well depth: <b>72</b> ft. Date of completion <b>5-28-71</b> Well diameter <b>8</b> in.	
	<b>Brown Surface Silt</b>		<b>6</b>	<b>6</b>	5 <input checked="" type="checkbox"/> Cable tool <input type="checkbox"/> Rotary <input type="checkbox"/> Driven <input type="checkbox"/> Dug <input type="checkbox"/> Hollow rod <input type="checkbox"/> Jetted <input type="checkbox"/> Bored <input type="checkbox"/> Reverse rotary	
	<b>Yellow Clay</b>		<b>7</b>	<b>46</b>	6 Use: <input checked="" type="checkbox"/> Domestic <input type="checkbox"/> Public supply <input type="checkbox"/> Industry <input type="checkbox"/> Irrigation <input type="checkbox"/> Air conditioning <input type="checkbox"/> Commercial <input type="checkbox"/> Test well	
	<b>Light Water Shale</b>		<b>47</b>	<b>48</b>	7 Casing: Material <b>RMP</b> Height: <b>above</b> / below Threaded <input type="checkbox"/> Welded <input type="checkbox"/> Surface <b>12</b> in. Diam. <b>6</b> in. to <b>52</b> ft. depth Drive shoe? <input type="checkbox"/> Yes <input checked="" type="checkbox"/> No <b>6</b> in. to <b>ft.</b> ft. depth!	
	<b>Light Gray Clay</b>		<b>49</b>	<b>65</b>	8 Screen: Manufacturer <b>Surfacing Plastic</b> Type <b>RMP</b> Dia. <b>6</b> Slot/gauze <b>20 ft</b> Length <b>20 ft</b> Set between <b>53</b> ft. and <b>72</b> ft.	
	<b>Gray Water Shale</b>		<b>66</b>	<b>68</b>	Fittings: Gravel pack <input checked="" type="checkbox"/> Yes <input type="checkbox"/> No Size range of material	
	<b>Dark Gray Clay</b>		<b>69</b>	<b>72</b>	9 Static water level: <b>50</b> ft. below land surface Date <b>5-28-71</b>	
					10 Pumping level below land surfaces: <b>54</b> ft. after <b>2</b> hrs. pumping <b>10</b> g.p.m. ft. after hrs. pumping g.p.m. Estimated maximum yield <b>20</b> g.p.m.	
					11 Water sample submitted: <input type="checkbox"/> Yes <input checked="" type="checkbox"/> No Date	
					12 Well head completion: <input type="checkbox"/> Pitless adapter <input checked="" type="checkbox"/> Inches above grade	
					13 Well grouted? <input checked="" type="checkbox"/> Yes <input type="checkbox"/> No <input checked="" type="checkbox"/> Neat cement <input type="checkbox"/> Bentonite <input type="checkbox"/> Depth: From <b>0</b> ft. to <b>12</b> ft.	
					14 Nearest source of possible contamination: ft. <b>60</b> Direction <b>NE</b> Type <b>Septic</b> Well disinfected upon completion? <input checked="" type="checkbox"/> Yes <input type="checkbox"/> No	
					15 Pump: Manufacturer's name <b>BURK</b> Not installed Model number <b>SN-13</b> HP <b>1/2</b> Volts <b>220</b> Length of drop pipe <b>47</b> ft. capacity <b>10</b> g.m.p. Type: <input checked="" type="checkbox"/> Submersible <input type="checkbox"/> Turbine <input type="checkbox"/> Jet <input type="checkbox"/> Reciprocating <input type="checkbox"/> Centrifugal <input type="checkbox"/> Other	
	(use a second sheet if needed)				16 Remarks: elevation <b>4x6 well House with concrete floor</b>	
					17 Water well contractor's certification: This well was drilled under my jurisdiction and this report is true to the best of my knowledge and belief. <b>SIMMONS DRILLING CO.</b> Business name <b>115 E CENTRAL ANDOVER</b> License No. Address <b>Box 300</b> Date <b>5-28-71</b> Signed <b>Bob Bongard</b> Authorized representative	
					Topography: <input type="checkbox"/> Hill <input type="checkbox"/> Slope <input checked="" type="checkbox"/> Upland <input type="checkbox"/> Valley	