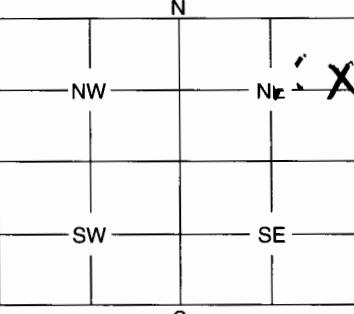


1	LOCATION OF WATER WELL: County: Butler	Fraction SE 1/4 NE 1/4 NE 1/4	Section Number 19	Township Number 27 S	Range Number 3 E
Distance and direction from nearest town or city street address of well if located within city? 345 N. Andover Road, Andover, Kansas					
2	WATER WELL OWNER: RR #, St. Address, Box #: 2 N. Nerada City, State, ZIP Code: Colorado Sp., CO 80903	Coastal Mart Inc # 7314 Board of Agriculture, Division of Water Resources Application Number:			
3	MARK WELL'S LOCATION WITH AN "X" IN SECTION BOX: 	4	DEPTH OF WELL 33.28 ft.	WELL'S STATIC WATER LEVEL Dry ft.	
			WELL WAS USED AS: 1 Domestic 5 Public Water Supply 2 Irrigation 6 Oil Field Water Supply 3 Feedlot 7 Domestic (Lawn & Garden) 4 Industrial 8 Air Conditioning 9 Dewatering 10 Monitoring Well 11 Injection Well 12 Other		
			Was a chemical / bacteriological sample submitted to Department? Yes No If yes, mo/day/yr sample was submitted Water Well Disinfected: Yes No X		
5	TYPE OF BLANK CASING USED: 1 Steel 3 RMP (SR) 5 Wrought 7 Fiberglass 9 Other (Specify below) 2 PVC 4 ABS 6 Asbestos-Cement 8 Concrete Tile				
	Blank casing diameter 2" in.	Was casing pulled?	Yes X	No	If yes, how much 3'
	Casing height above or below land surface	in.			
6	GROUT PLUG MATERIAL: 1 Neat cement 2 Cement grout 3 Bentonite 4 Other	3	33.28	0	Soil
	Grout Plug Intervals: From 3 ft. to 33.28 ft.			From ft. to ft., From 0 to 3 ft.	
	What is the nearest source of possible contamination: 1 Septic tank 6 Seepage pit 11 Fuel storage 16 Other (specify below) 2 Sewer lines 7 Pit privy 12 Fertilizer storage 3 Watertight sewer lines 8 Sewage lagoon 13 Insecticide storage 4 Lateral lines 9 Feedyard 14 Abandoned water well 5 Cess pool 10 Livestock pens 15 Oil well/Gas well				
	Direction from well? N	How many feet? 70'			
	FROM 0	TO 3	PLUGGING MATERIALS Soil		
	3	33.28	Bentonite		
7	CONTRACTOR'S OR LANDOWNER'S CERTIFICATION: This water well was plugged under my jurisdiction and was completed on (mo/day/year) 31/01/2007 and this record is true to the best of my knowledge and belief. Kansas Water Well Contractor's License No. 313012001 - This Water Well Record was completed on (mo/day/year) 31/01/2007 under the business name of MWH Americas, Inc by (signature) Kathy L. Dainger				
INSTRUCTIONS: Use typewriter or ball point pen. Please press firmly and print clearly. Please fill in blanks, underline or circle the correct answers. Send top three copies to Kansas Department of Health and Environment, Bureau of Water, Geology Section, 1000 SW Jackson St., Ste. 420, Topeka, Kansas 66612-1367. Telephone: 785/296-5522. Send one to Water Well Owner and retain one for your records.					