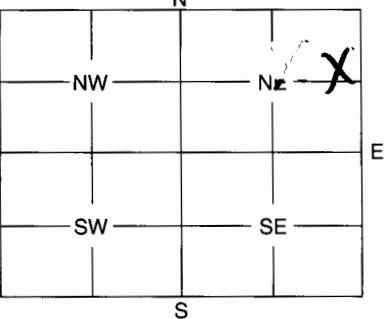


264507

1	LOCATION OF WATER WELL:	Fraction	Section	Number	Township	Number	Range	Number																								
County:	Bettler SE NE NE 19 27 S 3 E 0																															
Distance and direction from nearest town or city street address of well if located within city? 107 W. Central, Andover, Kansas																																
2	WATER WELL OWNER:	Coastal Mart Inc #17314 2 N. Nevada P.O. Springs, CO 80903																														
RR #, St. Address, Box #: City, State, ZIP Code			Board of Agriculture, Division of Water Resources Application Number:																													
3	MARK WELL'S LOCATION WITH AN "X" IN SECTION BOX:		4	DEPTH OF WELL 24.60 ft. WELL'S STATIC WATER LEVEL 21.70 ft.																												
		WELL WAS USED AS: <table> <tr><td>1 Domestic</td><td>5 Public Water Supply</td></tr> <tr><td>2 Irrigation</td><td>6 Oil Field Water Supply</td></tr> <tr><td>3 Feedlot</td><td>7 Domestic (Lawn & Garden)</td></tr> <tr><td>4 Industrial</td><td>8 Air Conditioning</td></tr> </table> 9 Dewatering 10 Monitoring Well 11 Injection Well 12 Other MW-4							1 Domestic	5 Public Water Supply	2 Irrigation	6 Oil Field Water Supply	3 Feedlot	7 Domestic (Lawn & Garden)	4 Industrial	8 Air Conditioning																
1 Domestic	5 Public Water Supply																															
2 Irrigation	6 Oil Field Water Supply																															
3 Feedlot	7 Domestic (Lawn & Garden)																															
4 Industrial	8 Air Conditioning																															
Was a chemical / bacteriological sample submitted to Department? Yes No If yes, mo/day/yr sample was submitted X																																
Water Well Disinfected: Yes No X																																
5	TYPE OF BLANK CASING USED:																															
1 Steel 2 PVC		3 RMP (SR) 4 ABS		5 Wrought 6 Asbestos-Cement		7 Fiberglass 8 Concrete Tile		9 Other (Specify below)																								
2"								X																								
Blank casing diameter in.		Was casing pulled? Yes X		No If yes, how much 3'																												
Casing height above or below land surface in.																																
6	GROUT PLUG MATERIAL:																															
Grout Plug Intervals:		1 Neat cement From ft.	2 Cement grout to ft.	3 Bentonite From ft.	4 Other Soil	5' to 3'																										
What is the nearest source of possible contamination:																																
1 Septic tank 2 Sewer lines 3 Watertight sewer lines 4 Lateral lines 5 Cess pool		6 Seepage pit 7 Pit privy 8 Sewage lagoon 9 Feedyard 10 Livestock pens		11 Fuel storage 12 Fertilizer storage 13 Insecticide storage 14 Abandoned water well 15 Oil well/Gas well		16 Other (specify below)																										
Direction from well? South		How many feet? 70'																														
<table border="1"> <thead> <tr> <th>FROM</th> <th>TO</th> <th>PLUGGING MATERIALS</th> </tr> </thead> <tbody> <tr> <td>3</td> <td>3</td> <td>Soil</td> </tr> <tr> <td>3</td> <td>24.60</td> <td>Bentonite</td> </tr> <tr> <td></td> <td></td> <td></td> </tr> </tbody> </table>									FROM	TO	PLUGGING MATERIALS	3	3	Soil	3	24.60	Bentonite															
FROM	TO	PLUGGING MATERIALS																														
3	3	Soil																														
3	24.60	Bentonite																														
7	CONTRACTOR'S OF LANDOWNER'S CERTIFICATION: This water well was plugged under my jurisdiction and was completed on (mo/day/year) 3/19/2007																															
and this record is true to the best of my knowledge and belief. Kansas Water Well Contractor's License No. 313012007																																
This Water Well Record was completed on (mo/day/year) 3/30/2007 under the business name of MWI Americas Inc																																

INSTRUCTIONS: Use typewriter or ball point pen. Please press firmly and print clearly. Please fill in blanks, underline or circle the correct answers. Send top three copies to Kansas Department of Health and Environment, Bureau of Water, Geology Section, 1000 SW Jackson St., Ste. 420, Topeka, Kansas 66612-1367. Telephone: 785/296-5522. Send one to Water Well Owner and retain one for your records.