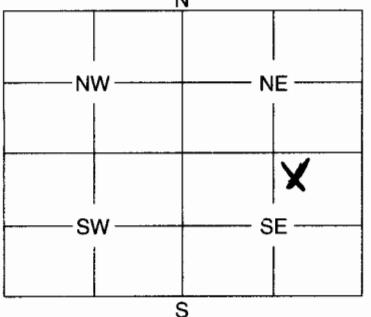


1	LOCATION OF WATER WELL:	Fraction	Section	Number	Township	Number	Range	Number																								
County: Butler		NW 1/4 NE 1/4 SE 1/4	9		27	3	EW																									
Distance and direction from nearest town or city street address of well if located within city? 2 miles East & 1/2 mile North of Andover, Ks.																																
2	WATER WELL OWNER: Turnkey, Inc. c/o Kim Quastad RR #, St. Address, Box #: 118 E. 13th City, State, ZIP Code : Andover, Ks. 67002 Board of Agriculture, Division of Water Resources Application Number:																															
3	MARK WELL'S LOCATION WITH AN "X" IN SECTION BOX:	4	DEPTH OF WELL 400 ft. WELL'S STATIC WATER LEVEL 45 ft.																													
		WELL WAS USED AS: <table> <tr><td>1 Domestic</td><td>5 Public Water Supply</td><td>9 Dewatering</td></tr> <tr><td>2 Irrigation</td><td>6 Oil Field Water Supply</td><td>10 Monitoring Well</td></tr> <tr><td>3 Feedlot</td><td>7 Domestic (Lawn & Garden)</td><td>11 Injection Well</td></tr> <tr><td>4 Industrial</td><td>8 Air Conditioning</td><td>X2 Other <u>Geo-thermal</u></td></tr> </table>							1 Domestic	5 Public Water Supply	9 Dewatering	2 Irrigation	6 Oil Field Water Supply	10 Monitoring Well	3 Feedlot	7 Domestic (Lawn & Garden)	11 Injection Well	4 Industrial	8 Air Conditioning	X2 Other <u>Geo-thermal</u>												
1 Domestic	5 Public Water Supply	9 Dewatering																														
2 Irrigation	6 Oil Field Water Supply	10 Monitoring Well																														
3 Feedlot	7 Domestic (Lawn & Garden)	11 Injection Well																														
4 Industrial	8 Air Conditioning	X2 Other <u>Geo-thermal</u>																														
Was a chemical / bacteriological sample submitted to Department? Yes No X If yes, mo/day/yr sample was submitted																																
Water Well Disinfected: Yes X No																																
5	TYPE OF BLANK CASING USED: 1 Steel 3 RMP (SR) 5 Wrought 7 Fiberglass X9 Other (Specify below) 2 PVC 4 ABS 6 Asbestos-Cement 8 Concrete Tile Polyethylene																															
Blank casing diameter 3 1/4 in. Was casing pulled? Yes No If yes, how much																																
Casing height above or below land surface in.																																
6	GROUT PLUG MATERIAL: 1 Neat cement 2 Cement grout 3X Bentonite 4 Other																															
Grout Plug Intervals: From 5 ft. to 200 ft. X4 From ft. to ft., From to ft.																																
What is the nearest source of possible contamination: <table> <tr><td>1 Septic tank</td><td>6 Seepage pit</td><td>11 Fuel storage</td><td>16 Other (specify below)</td></tr> <tr><td>X Sewer lines</td><td>7 Pit privy</td><td>12 Fertilizer storage</td><td>.....</td></tr> <tr><td>3 Watertight sewer lines</td><td>8 Sewage lagoon</td><td>13 Insecticide storage</td><td>.....</td></tr> <tr><td>4 Lateral lines</td><td>9 Feedyard</td><td>14 Abandoned water well</td><td>.....</td></tr> <tr><td>5 Cess pool</td><td>10 Livestock pens</td><td>15 Oil well/Gas well</td><td>.....</td></tr> </table>									1 Septic tank	6 Seepage pit	11 Fuel storage	16 Other (specify below)	X Sewer lines	7 Pit privy	12 Fertilizer storage	3 Watertight sewer lines	8 Sewage lagoon	13 Insecticide storage	4 Lateral lines	9 Feedyard	14 Abandoned water well	5 Cess pool	10 Livestock pens	15 Oil well/Gas well				
1 Septic tank	6 Seepage pit	11 Fuel storage	16 Other (specify below)																													
X Sewer lines	7 Pit privy	12 Fertilizer storage																													
3 Watertight sewer lines	8 Sewage lagoon	13 Insecticide storage																													
4 Lateral lines	9 Feedyard	14 Abandoned water well																													
5 Cess pool	10 Livestock pens	15 Oil well/Gas well																													
Direction from well? North How many feet? 120 ft.																																
<table border="1"> <thead> <tr> <th>FROM</th> <th>TO</th> <th>Log XXXXXXXXXXXX</th> </tr> </thead> <tbody> <tr><td>0</td><td>3</td><td>Topsoil</td></tr> <tr><td>3</td><td>14</td><td>Clay, tan</td></tr> <tr><td>14</td><td>52</td><td>Shale, gray-soft</td></tr> <tr><td>52</td><td>68</td><td>Shale, gray w/fractures</td></tr> <tr><td>68</td><td>120</td><td>Shale, light gray</td></tr> <tr><td>120</td><td>164</td><td>Limestone</td></tr> <tr><td>164</td><td>166</td><td>Fractured limestone</td></tr> </tbody> </table>									FROM	TO	Log XXXXXXXXXXXX	0	3	Topsoil	3	14	Clay, tan	14	52	Shale, gray-soft	52	68	Shale, gray w/fractures	68	120	Shale, light gray	120	164	Limestone	164	166	Fractured limestone
FROM	TO	Log XXXXXXXXXXXX																														
0	3	Topsoil																														
3	14	Clay, tan																														
14	52	Shale, gray-soft																														
52	68	Shale, gray w/fractures																														
68	120	Shale, light gray																														
120	164	Limestone																														
164	166	Fractured limestone																														
7	CONTRACTOR'S OF LANDOWNER'S CERTIFICATION: This water well was plugged under my jurisdiction and was completed on (mo/day/year) 8/29/08 and this record is true to the best of my knowledge and belief. Kansas Water Well Contractor's License No. 138 This Water Well Record was completed on (mo/day/year) 9/5/08 Under the business name of Peterson Irrigation, Inc. by (signature) <i>Mike Bellino</i>																															
INSTRUCTIONS: Use typewriter or ball point pen. Please press firmly and print clearly. Please fill in blanks, underline or circle the correct answers. Send top three copies to Kansas Department of Health and Environment, Bureau of Water, Geology Section, 1000 SW Jackson St., Ste. 420, Topeka, Kansas 66612-1367. Telephone: 785/296-5522. Send one to Water Well Owner and retain one for your records.																																