

WATER WELL RECORD

Form WWC-5

Division of Water Resources App. No. _____

1 LOCATION OF WATER WELL:

Fraction

1/4 NE 1/4 SW 1/4 SE 1/4

County: ButlerStreet/Rural Address of Well Location; if unknown, distance & direction from nearest town or intersection: If at owner's address, check here

Section Number

17

Township No.

T

20S

Range Number

R

3 E W

2 WATER WELL OWNER:

Jim Gerhart

RR#, Street Address, Box #:

1018 Rosemont Ct.

City, State, ZIP Code

Andover KS

Global Positioning System (GPS) information:

Latitude: (in decimal degrees)

Longitude: (in decimal degrees)

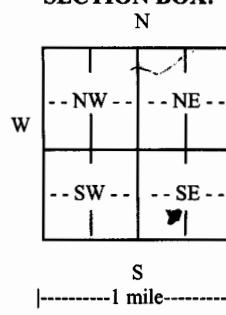
Elevation:

Datum: WGS 84, NAD 83, NAD 27

Collection Method:

 GPS unit (Make/Model: Digital Map/Photo, Topographic Map, Land SurveyEst. Accuracy: <3 m, 3-5 m, 5-15 m, >15 m

3 LOCATE WELL WITH AN "X" IN SECTION BOX:

4 DEPTH OF COMPLETED WELL 70 ft.

Depth(s) Groundwater Encountered (1) ft. (2) ft. (3) ft.

WELL'S STATIC WATER LEVEL 21 ft. below land surface measured on mo/day/yr.

Pump test data: Well water was ft. after hours pumping gpm

EST. YIELD gpm. Well water was ft. after hours pumping gpm

Bore Hole Diameter 12 in. to 70 ft. and in. to ft.WELL WATER TO BE USED AS: Public water supply Geothermal Injection well Domestic Feedlot Oil field water supply Dewatering Other (Specify below) Irrigation Industrial Domestic-lawn & garden Monitoring wellWas a chemical/bacteriological sample submitted to Department? Yes No

If yes, mo/day/yr sample was submitted.....

Water well disinfected? Yes No5 TYPE OF CASING USED: Steel PVC OtherCASING JOINTS: Glued Clamped Welded ThreadedCasing diameter 5 in. to 70 ft., Diameter in. to ft., Diameter in. to ft.Casing height above land surface 16 in., Weight 160 lbs./ft., Wall thickness or gauge No. 26

TYPE OF SCREEN OR PERFORATION MATERIAL:

 Steel Stainless Steel PVC Other (Specify) Brass Galvanized Steel None used (open hole)

SCREEN OR PERFORATION OPENINGS ARE:

 Continuous slot Mill slot Gauze wrapped Torch cut Drilled holes None (open hole) Louvered shutter Key punched Wire wrapped Saw cut Other (specify)SCREEN-PERFORATED INTERVALS: From 30 ft. to 70 ft., From ft. to ft.

From ft. to ft., From ft. to ft. to ft.

GRAVEL PACK INTERVALS: From 24 ft. to 70 ft., From ft. to ft.

From ft. to ft., From ft. to ft.

6 GROUT MATERIAL: Neat cement Cement grout Bentonite OtherGrout Intervals: From 4 ft. to 24 ft., From ft. to ft., From ft. to ft.

What is the nearest source of possible contamination:

 Septic tank Lateral lines Pit privy Livestock pens Insecticide storage Other (specify below) Sewer lines Cesspool Sewage lagoon Fuel storage Abandoned water well Watertight sewer lines Seepage pit Feedyard Fertilizer storage Oil well/gas wellDirection from well South Distance from well 105'

FROM TO LITHOLOGIC LOG FROM TO LITHO. LOG (cont.) or PLUGGING INTERVALS

8 2 Top Soil

9 7 Clay

67 70 Blue Shale

67 70 Limestone

7 CONTRACTOR'S OR LANDOWNER'S CERTIFICATION: This water well was constructed, reconstructed, or plugged under my jurisdiction and was completed on (mo/day/year) 4/18/10 and this record is true to the best of my knowledge and belief.Kansas Water Well Contractor's License No. 991 This Water Well Record was completed on (mo/day/year) 5/14/10under the business name of Chase Drilling by (signature) David

INSTRUCTIONS: Use typewriter or ball point pen. PLEASE PRESS FIRMLY and PRINT clearly. Please fill in blanks and check the correct answers. Send three copies (white, blue, pink) to Kansas Department of Health and Environment, Bureau of SW Water Quality Section, 1000 SW Jackson St., Suite 420, Topeka, Kansas 66121-2367