


1 LOCATION OF WATER WELL:	Fraction County: Butler	NE $\frac{1}{4}$	NW $\frac{1}{4}$	Section Number 7	Township Number T 27 S	Range Number R 3	E/W
---------------------------	----------------------------	------------------	------------------	---------------------	---------------------------	---------------------	-----

Distance and direction from nearest town or city street address of well if located within city?

N easement near path W of 1023 W Mountain, Andover

2 WATER WELL OWNER:	NuStar Operating Pipeline P'ship LP RR#, St. Address, Box # : 19003 IH-10 West City, State, ZIP Code : San Antonio, TX 78257	Board of Agriculture, Division of Water Resources Application Number:
---------------------	--	--

3 LOCATE WELL'S LOCATION WITH AN "X" IN SECTION BOX:	4 DEPTH OF COMPLETED WELL 60 ft. ELEVATION: 1351.05 ft.
--	---

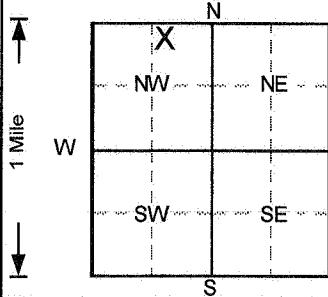

Depth(s) Groundwater Encountered 1 ft. 2 ft. 3 ft.

WELL'S STATIC WATER LEVEL 43.4 ft. below land surface measured on mo/day/yr 9/30/2013

Pump test data: Well water was NA ft. after hours pumping gpm

Est. Yield NA gpm: Well water was ft. after hours pumping gpm

Bore Hole Diameter 8 in. to 66 ft. and in. to ft.

WELL WATER TO BE USED AS: 5 Public water supply 8 Air conditioning 11 Injection well

1 Domestic 3 Feedlot 6 Oil field water supply 9 Dewatering 12 Other (Specify below)

2 Irrigation 4 Industrial 7 Lawn and garden only 10 Monitoring well

Was a chemical/bacteriological sample submitted to Department? Yes No If yes, mo/day/yr sample was submitted

Water Well Disinfected? Yes No ✓

OFFICE USE ONLY

5 TYPE OF BLANK CASING USED:	5 Wrought iron 8 Concrete tile Casing joints: Glued Clamped
------------------------------	---

1 Steel	3 RMP (SR)	6 Asbestos-Cement	9 Other (specify below)	Welded
2 PVC	4 ABS	7 Fiberglass		Threaded. ✓

Blank casing diameter 2 in. to 40 ft. Dia in. to ft. Dia in. to ft.

Casing height above land surface -6.96 in. weight lbs./ft. Wall thickness or gauge No. Sch. 40

TYPE OF SCREEN OR PERFORATION MATERIAL	7 PVC	10 Asbestos-cement
--	-------	--------------------

1 Steel	3 Stainless steel	5 Fiberglass	8 RMP (SR)	11 Other (specify)
2 Brass	4 Galvanized steel	6 Concrete tile	9 ABS	12 None used (open hole)

SCREEN OR PERFORATION OPENINGS ARE:

1 Continuous slot	3 Mill slot	5 Gauzed wrapped	8 Saw cut	11 None (open hole)
2 Louvered shutter	4 Key punched	6 Wire wrapped	9 Drilled holes	10 Other (specify)

SCREEN-PERFORATED INTERVALS: From 40 ft. to 60 ft. From ft. to ft.

From ft. to ft. From ft. to ft.

GRAVEL PACK INTERVALS: From 38 ft. to 66 ft. From ft. to ft.

From ft. to ft. From ft. to ft.

6 GROUT MATERIAL:	1 Neat cement	2 Cement grout	3 Bentonite	4 Other
-------------------	---------------	----------------	-------------	---------------

Grout Intervals: From 0 ft. to 2 ft. From 2 ft. to 38 ft. From ft. to ft.

What is the nearest source of possible contamination:

1 Septic tank	4 Lateral lines	7 Pit privy	10 Livestock pens	14 Abandoned water well
2 Sewer lines	5 Cess pool	8 Sewage lagoon	11 Fuel storage	15 Oil well/Gas well
3 Watertight sewer lines	6 Seepage pit	9 Feedyard	12 Fertilizer storage	16 Other (specify below)

Direction from well?

FROM	TO	LITHOLOGIC LOG	FROM	TO	PLUGGING INTERVALS
0	6	Grass over silty Clay, V. Dark Gray			
6	11.5	Clay, silty, Lt. Olive Gray			
11.5	15	Clay, gravelly, Pale Olive			
15	20	Clay, Lt. Olive Gray to Yellow			
20	35	Refusal at 20',			
20	35	Shale w/Mudstone, Lt. Olive Brown			
35	40	Clay w/Mudstone, Brown			
40	50	Clay w/Mudstone, gravelly, Brownish Gray			
50	55	Mudstone, Lt. Brown, w/Clay			
55	60	Clay w/Gravel, Brownish Gray			
60	65	Gravel w/Clay, Lt. Brown			
65	66	Sand w/Gravel, Lt. Reddish Brown			
					MW3, Flushmount

7 CONTRACTOR'S OR LANDOWNER'S CERTIFICATION:	This water well was (1) constructed, (2) reconstructed, or (3) plugged under my jurisdiction and was completed on (mo/day/year) 7/24/2013 and this record is true to the best of my knowledge and belief.
--	---

Kansas Water Well Contractor's License No. 527 This Water Well Record was completed on (mo/day/yr) 10/28/13 under the business name of GeoCore, Inc. by (signature) *Jesse Hill*