


WATER WELL RECORD Form WWC-5 KSA 82a-1212

1 LOCATION OF WATER WELL: Butler	FRACTION NW 1/4 NW 1/4 SE 1/4	SECTION NUMBER 17	TOWNSHIP NUMBER T 27 S	RANGE NUMBER R 3E E/W
--	---	-----------------------------	----------------------------------	---------------------------------

Distance and direction from nearest town or city street address of well if located within city?
728 Deer Field Andover, Kansas

2 WATER WELL OWNER: GEARHART HOMES, Jim	Board of Agriculture, Division of Water Resource
RR#,ST. ADDRESS,BOX #: 1111 N. Coachouse Ct.	Application Number:
CITY, STATE: Wichita, Kansas	ZIP CODE:

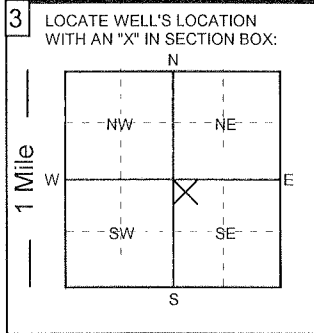

4 DEPTH OF COMPLETED WELL: 84 ft.	ELEVATION:
Depth of groundwater Encountered:	ft.
WELL'S STATIC WATER LEVEL 30 FT. BELOW LAND SURFACE MEASURED ON 7/25/14	mo/day/yr:
Pump test data:	Well water was _____ ft. after _____ hours of pumping @ _____ gpm
Est. Yield:	Well water was _____ ft. after _____ hours of pumping @ _____ gpm
Bore Hole Diameter 12 in. to 84 ft. and _____ in. to _____ ft.	
WELL WATER TO BE USED AS:	
1. Domestic	3. Feedlot
5. Public water supply	7. Lawn and garden only
9. Dewatering	11. Injection well
12. Other (Specify below)	
2. Irrigation	4. Industrial
6. Oil field water supply	8. Air conditioning
10. Monitoring well	
Was a chemical/bacteriological sample submitted to Department?	YES <input type="radio"/> NO <input checked="" type="radio"/>
Was Water Well Disinfected?	<input checked="" type="radio"/> YES <input type="radio"/> NO

5 TYPE OF CASING USED:	1. Steel	3. RPM (SR)	5. Wrought Iron	7. Fiberglass	9. Other (Specify below)	CASING JOINTS: <input checked="" type="radio"/> Glued <input type="radio"/> Threaded
	<input checked="" type="radio"/> 2. PVC	4. ABS	6. Asbestos-Cement	8. Concrete tile	SDR-26	<input type="radio"/> Welded <input type="radio"/> Clamped
Blank casing diameter	5 in.	to 40 ft.,	Dia. _____ in.	to _____ ft.,	Dia. _____ in.	to _____ ft.
Casing height above land surface:	12 in.,	Weight: 2.35 lbs. / ft.	Wall thickness or gauge No. .214			
TYPE OF SCREEN OR PERFORATION MATERIAL:						
1. Steel	3. Stainless Steel	5. Fiberglass	<input checked="" type="radio"/> 7. PVC	9. ABS	11. Other (specify)	
2. Brass	4. Galvanized	6. Concrete Tile	8. RMP (SR)	10. Asbestos-Cement	12. None used (open hole)	
SCREEN OR PERFORATION OPENINGS ARE:						
1. Continuous slot	3. Mill slot	5. Gauzed wrapped	7. Torch cut	9. Drilled holes	11. None (open hole)	
2. Louvered shutter	4. Key punched	6. Wire wrapped	<input checked="" type="radio"/> 8. Saw cut	10. Other (specify)		
SCREEN - PERFORATION INTERVAL	From 40 ft.	to 84 ft.,	From _____ ft.	to _____ ft.	From _____ ft.	to _____ ft.
GRAVEL PACK INTERVALS:	From 24 ft.	to 84 ft.,	From _____ ft.	to _____ ft.	From _____ ft.	to _____ ft.

6 GROUT MATERIALS:	1. Neat cement	2. Cement Grout	3. Bentonite	Other bentonite hole plug
Grout Intervals:	From 4 ft.	to 24 ft.,	From _____ ft.	to _____ ft., From _____ ft. to _____ ft.
What is the nearest source of possible contamination:				
1. Septic tank	4. Lateral lines	7. Pit privy	10. Livestock pens	13. Insecticide storage
2. Sewer lines	5. Cess Pool	8. Sewage lagoon	11. Fuel storage	14. Abandon water well
<input checked="" type="radio"/> 3. Watertight sewer line	6. Seepage pit	9. Feed yard	12. Fertilizer storage	15. Oil well/Gas well
				16. Other (specify below)
Direction from well?	North	How many feet?	10 ft. plus	

From	To	LITHOLOGIC LOG	From	To	LITHOLOGIC LOG
0	3	topsoil			
3	8	clay			
8	84	gray shale			

7 Contractor's or Landowner's Certification: This water well was 1. constructed 2. reconstructed or 3. plugged under my jurisdiction and was completed on (mo/day/year) **7/25/14** and this record is true to the best of my knowledge and belief.

Kansas Water Well Contractor's License No. 236 This water well record was completed on (mo/day/year) **7/25/2014**

under the business name of **Harp Well and Pump Service** by (signature) **Todd S. Harp**