


WATER WELL RECORD Form WWC-5 KSA 82a-1212

1 LOCATION OF WATER WELL: BUTLER FRACTION SW 1/4 SW 1/4 SE 1/4 SECTION NUMBER 17 TOWNSHIP NUMBER T 27 S RANGE NUMBER R 3E E/W

Distance and direction from nearest town or city street address of well if located within city? 1105 E. Rosemont Andover, Kansas

2 WATER WELL OWNER: H & H HOMEBUILDERS INC. RR#,ST. ADDRESS,BOX #: 3906 N. Lakecrest CITY, STATE: Wichita, Kansas

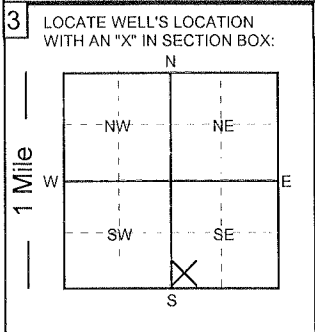

4 DEPTH OF COMPLETED WELL: 97 ft. ELEVATION: Depth of groundwater Encountered: 35 FT. BELOW LAND SURFACE MEASURED ON 9/22/14

5 TYPE OF CASING USED: 2. PVC, 5. Wrought Iron, 9. Other (Specify below) SDR-26 CASING JOINTS: Glued

6 GROUT MATERIALS: 3. Bentonite Other bentonite hole plug Grout Intervals: From 4 ft. to 24 ft.

Table with columns: From, To, LITHOLOGIC LOG. Rows: 0-3 topsoil, 3-12 clay, 12-94 gray shale, 94-97 limestone

7 Contractor's or Landowner's Certification: This water well was 1. constructed 2. reconstructed or 3. plugged under my jurisdiction and was completed on 9/22/2014