


WATER WELL RECORD Form WWC-5 KSA 82a-1212

1 LOCATION OF WATER WELL: Butler	FRACTION SW 1/4 SW 1/4 SE 1/4	SECTION NUMBER 6	TOWNSHIP NUMBER T 27 S	RANGE NUMBER R 3E E/W
--	---	----------------------------	----------------------------------	---------------------------------

Distance and direction from nearest town or city street address of well if located within city?
702 Candlestar Ct. Andover, Kansas

2 WATER WELL OWNER: GRAY, Paul Homes, LLC	RR#,ST. ADDRESS,BOX #: 1861 N. Rock Road #200	CITY, STATE: Wichita, Kansas	ZIP CODE: 67203
Board of Agriculture, Division of Water Resource		Application Number:	

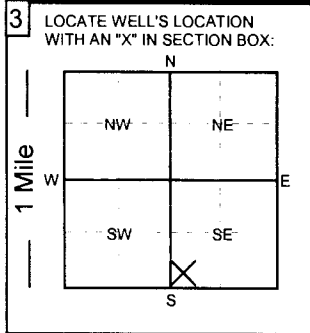

4 DEPTH OF COMPLETED WELL: 110 ft.	ELEVATION: ft.	Pump test data: Well water was _____ ft. after _____ hours of pumping @ _____ gpm	WELL'S STATIC WATER LEVEL: 60 FT. BELOW LAND SURFACE MEASURED ON 11/11/14
Depth of groundwater Encountered: _____ ft.		Est. Yield: _____ gpm	
Bore Hole Diameter 12 in. to 110 ft. and _____ in. to _____ ft.		WELL WATER TO BE USED AS:	
1. Domestic 3. Feedlot 5. Public water supply 7. Lawn and garden only 9. Dewatering 11. Injection well		2. Irrigation 4. Industrial 6. Oil field water supply 8. Air conditioning 10. Monitoring well 12. Other (Specify below)	
Was a chemical/bacteriological sample submitted to Department? YES NO		If yes, what _____ mo/day/yr was sample submitted	
Was Water Well Disinfected? YES NO			

5 TYPE OF CASING USED: 1. Steel 3. RPM (SR) 5. Wrought Iron 7. Fiberglass 9. Other (Specify below)	CASING JOINTS: Glued Threaded Welded Clamped
2. PVC 4. ABS 6. Asbestos-Cement 8. Concrete tile SDR-26	
Blank casing diameter 5 in. to 60 ft., Dia. in. to _____ ft., Dia. in. to _____ ft.	
Casing height above land surface: 12 in., Weight: 2.35 lbs. / ft. Wall thickness or gauge No. .214	
TYPE OF SCREEN OR PERFORATION MATERIAL: 1. Steel 3. Stainless Steel 5. Fiberglass 7. PVC 9. ABS 11. Other (specify)	
2. Brass 4. Galvanized 6. Concrete Tile 8. RMP (SR) 10. Asbestos-Cement 12. None used (open hole)	
SCREEN OR PERFORATION OPENINGS ARE: 1. Continuous slot 3. Mill slot 5. Gauzed wrapped 7. Torch cut 9. Drilled holes 11. None (open hole)	
2. Louvered shutter 4. Key punched 6. Wire wrapped 8. Saw cut 10. Other (specify)	
SCREEN - PERFORATION INTERVAL From 60 ft. to 110 ft., From _____ ft. to _____ ft.	
GRAVEL PACK INTERVALS: From 24 ft. to 110 ft., From _____ ft. to _____ ft.	

6 GROUT MATERIALS: 1. Neat cement 2. Cement Grout 3. Bentonite Other bentonite hole plug	Grout Intervals: From 4 ft. to 24 ft., From _____ ft. to _____ ft.
What is the nearest source of possible contamination: 1. Septic tank 4. Lateral lines 7. Pit privy 10. Livestock pens 13. Insecticide storage 15. Oil well/Gas well	
2. Sewer lines 5. Cess Pool 8. Sewage lagoon 11. Fuel storage 14. Abandon water well 16. Other (specify below)	
3. Watertight sewer line 6. Seepage pit 9. Feed yard 12. Fertilizer storage	
Direction from well? South How many feet? 20 ft. plus	

From	To	LITHOLOGIC LOG	From	To	LITHOLOGIC LOG
0	3	topsoil			
3	8	clay			
8	65	brown shale			
65	110	grey shale			

7 Contractor's or Landowner's Certification: This water well was 1. constructed 2. reconstructed or 3. plugged under my jurisdiction and was completed on (mo/day/year) 11/01/2014	and this record is true to the best of my knowledge and belief.
Kansas Water Well Contractor's License No. 236	This water well record was completed on (mo/day/year) 11/12/2014
under the business name of Harp Well and Pump Service	by (signature) <i>Todd S. Harp</i>