


WATER WELL RECORD Form WWC-5 KSA 82a-1212

1 LOCATION OF WATER WELL: BUTLER FRACTION NE 1/4 SE 1/4 SW 1/4 SECTION NUMBER 19 TOWNSHIP NUMBER T 27 S RANGE NUMBER R 3E E/W

Distance and direction from nearest town or city street address of well if located within city? 239 Fairway Circle Andover, Kansas

2 WATER WELL OWNER: STINSON, Ried Board of Agriculture, Division of Water Resource RR#.ST. ADDRESS,BOX #: 239 Fairway Circle CITY, STATE: Andover, Kansas ZIP CODE: Application Number:

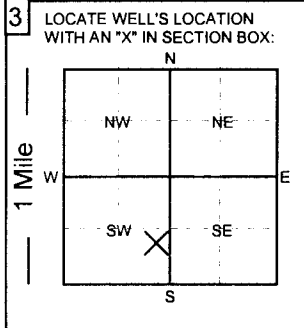

4 DEPTH OF COMPLETED WELL: 95 ft. ELEVATION: Depth of groundwater Encountered: WELL'S STATIC WATER LEVEL 40 FT. BELOW LAND SURFACE MEASURED ON mo/day/yr: 4/16 Pump test data: Well water was ft. after hours of pumping @ gpm Est. Yield: gpm Well water was ft. after hours of pumping @ gpm Bore Hole Diameter 12 in. to 95 ft. and in. to ft. WELL WATER TO BE USED AS: 1. Domestic 3. Feedlot 5. Public water supply 7. Lawn and garden only 9. Dewatering 11. Injection well 2. Irrigation 4. Industrial 6. Oil field water supply 8. Air conditioning 10. Monitoring well 12. Other (Specify below) Was a chemical/bacteriological sample submitted to Department? YES NO ; If yes, what mo/day/yr was sample submitted Was Water Well Disinfected? YES NO

5 TYPE OF CASING USED: 1. Steel 2. PVC 3. RPM (SR) 4. ABS 5. Wrought Iron 6. Asbestos-Cement 7. Fiberglass 8. Concrete tile 9. Other (Specify below) CASING JOINTS: Glued Threaded Welded Clamped Blank casing diameter 5 in. to 40 ft., Dia. in. to ft., Dia. in. to ft. Casing height above land surface: 12 in., Weight: 2.35 lbs. / ft. Wall thickness or gauge No. .214 TYPE OF SCREEN OR PERFORATION MATERIAL: 1. Steel 2. Brass 3. Stainless Steel 4. Galvanized 5. Fiberglass 6. Concrete Tile 7. PVC 8. RMP (SR) 9. ABS 10. Asbestos-Cement 11. Other (specify) 12. None used (open hole) SCREEN OR PERFORATION OPENINGS ARE: 1. Continuous slot 2. Louvered shutter 3. Mill slot 4. Key punched 5. Gauzed wrapped 6. Wire wrapped 7. Torch cut 8. Saw cut 9. Drilled holes 10. Other (specify) 11. None (open hole) SCREEN - PERFORATION INTERVAL From 40 ft. to 95 ft., From ft. to ft., From ft. to ft. GRAVEL PACK INTERVALS: From 24 ft. to 95 ft., From ft. to ft., From ft. to ft.

6 GROUT MATERIALS: 1. Neat cement 2. Cement Grout 3. Bentonite Other bentonite hole plug Grout Intervals: From 4 ft. to 24 ft., From ft. to ft., From ft. to ft. What is the nearest source of possible contamination: 1. Septic tank 2. Sewer lines 3. Watertight sewer line 4. Lateral lines 5. Cess Pool 6. Seepage pit 7. Pit privy 8. Sewage lagoon 9. Feed yard 10. Livestock pens 11. Fuel storage 12. Fertilizer storage 13. Insecticide storage 14. Abandon water well 15. Oil well/Gas well 16. Other (specify below) Direction from well? North How many feet? 10 ft. plus

From	To	LITHOLOGIC LOG	From	To	LITHOLOGIC LOG
0	3	topsoil			
3	8	clay			
8	45	brown shale			
45	95	grey shale			

7 Contractor's or Landowner's Certification: This water well was 1. constructed 2. reconstructed or 3. plugged under my jurisdiction and was completed on (mo/day/year) 4/1/16 and this record is true to the best of my knowledge and belief. Kansas Water Well Contractor's License No. 236 This water well record was completed on (mo/day/year) 4/4/16 under the business name of Harp Well and Pump Service by (signature) Todd S. Harp