


WATER WELL RECORD Form WWC-5 KSA 82a-1212

1 LOCATION OF WATER WELL: Butler	FRACTION SW 1/4 SW 1/4 NE 1/4	SECTION NUMBER 6	TOWNSHIP NUMBER T 27 S	RANGE NUMBER R 3E E/W
--	----------------------------------	---------------------	---------------------------	--------------------------

Distance and direction from nearest town or city street address of well if located within city?
2411 N. Silverdale **Andover, Kansas**

2 WATER WELL OWNER: RR# ST, ADDRESS, BOX # CITY, STATE:	SHARP HOMES 2131 N. Collective Ste. #A Wichita, Kansas	Board of Agriculture, Division of Water Resource Application Number: ZIP CODE: 67206
--	---	---

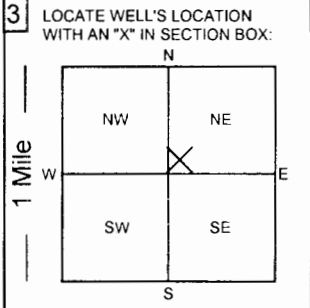

4 DEPTH OF COMPLETED WELL: 98 ft.	ELEVATION:
Depth of groundwater Encountered:	ft.
WELL'S STATIC WATER LEVEL	38 FT. BELOW LAND SURFACE MEASURED ON mo/day/yr: 2/16/17
Pump test data:	Well water was _____ ft. after _____ hours of pumping @ _____ gpm
Est. Yield:	gpm Well water was _____ ft. after _____ hours of pumping @ _____ gpm
Bore Hole Diameter	12 in. to 98 ft. and _____ in. to _____ ft.
WELL WATER TO BE USED AS:	1. Domestic 3. Feedlot 5. Public water supply 7. Lawn and garden only 9. Dewatering 11. Injection well 2. Irrigation 4. Industrial 6. Oil field water supply 8. Air conditioning 10. Monitoring well 12. Other (Specify below)
Was a chemical/bacteriological sample submitted to Department?	YES <input type="radio"/> NO <input checked="" type="radio"/> ; If yes, what mo/day/yr was sample submitted _____
Was Water Well Disinfected?	<input checked="" type="radio"/> YES NO

5 TYPE OF CASING USED:	1. Steel 3. RPM (SR) 5. Wrought Iron 7. Fiberglass 9. Other (Specify below) 2. PVC 4. ABS 6. Asbestos-Cement 8. Concrete tile SDR-26	CASING JOINTS: <input checked="" type="radio"/> Glued Threaded Welded Clamped
-------------------------------	---	--

Blank casing diameter 5 in. to 50 ft., Dia. in. to ft.	Casing height above land surface: 12 in., Weight: 2.35 lbs. / ft. Wall thickness or gauge No. .214
TYPE OF SCREEN OR PERFORATION MATERIAL:	
1. Steel 3. Stainless Steel 5. Fiberglass 7. PVC 9. ABS 11. Other (specify) 2. Brass 4. Galvanized 6. Concrete Tile 8. RMP (SR) 10. Asbestos-Cement 12. None used (open hole)	

SCREEN OR PERFORATION OPENINGS ARE:			
1. Continuous slot	3. Mill slot	5. Gauzed wrapped	7. Torch cut
2. Louvered shutter	4. Key punched	6. Wire wrapped	8. Saw cut
9. Drilled holes	11. None (open hole)		
SCREEN - PERFORATION INTERVAL	From 50 ft. to 98 ft.,	From _____ ft. to _____ ft.	
GRAVEL PACK INTERVALS:	From 24 ft. to 98 ft.,	From _____ ft. to _____ ft.	

6 GROUT MATERIALS:	1. Neat cement 2. Cement Grout 3. Bentonite Other bentonite hole plug	Grout Intervals: From 4 ft. to 24 ft., From _____ ft. to _____ ft.	
What is the nearest source of possible contamination:			
1. Septic tank	4. Lateral lines	7. Pit privy	10. Livestock pens
2. Sewer lines	5. Cess Pool	8. Sewage lagoon	11. Fuel storage
3. Watertight sewer line	6. Seepage pit	9. Feed yard	12. Fertilizer storage
Direction from well? North			How many feet? 10 ft. plus

From	To	LITHOLOGIC LOG	From	To	LITHOLOGIC LOG
0	3	topsoil			
3	10	clay			
10	35	brown shale			
35	95	gray shale			
95	98	limestone			

7 Contractor's or Landowner's Certification: This water well was 1. constructed 2. reconstructed or 3. plugged under my jurisdiction and was completed on (mo/day/year) 2/16/17 and this record is true to the best of my knowledge and belief.	
Kansas Water Well Contractor's License No. 236	This water well record was completed on (mo/day/year) 2/20/17
under the business name of Harp Well and Pump Service	by (signature) <i>Todd S. Harp</i>