


		RECORD		WWC-5		2118		sion of Wate			XX7 11 T				
Original Record       Correction       Chan         1       LOCATION OF WATER WELL:			e in Well U Fraction		Resources A Section N				Well ID		Number				
County:					4 1/4			T S		er Range Number $R \square E \square W$					
· · · · · · · · · · · · · · · · · · ·								treet or Rural Address where well is located (if unknown, distance and							
Business:		Last Walle.		rection from nearest town or intersection): If at owner's address, check here:											
Address:										, , , , , , , , , , , , , , , , , , , ,		,			
Address: City:			State:	ZIP:											
3 LOCATE WELL															
WITH "			PLETED WELL: ft.				5 Latitude:(decimal degrees)								
SECTIO		Groundwater Encountered: 1)					Longitude:(decimal degrees)								
1	N		2) ft. 3) ft., or 4) □ I WELL'S STATIC WATER LEVEL:							WGS 84 🗌 NAI		] NA	D 27		
	X		below land surface, measured on (mo-day-yr)							Latitude/Longitude nit make/model:			)		
NW	NE 1		above land surface, measured on (mo-day-yr)							VAAS enabled?					
			Pump test data: Well water was ft.					□ Land Survey □ Topographic Map				, ,			
w	E	after	after hours pumping						nline	Mapper:		- 			
SW	SE	often	Well water was ft.												
			after hours pumping gpm Estimated Yield:gpm					6 Eleva	Elevation:ft. 🗆 Ground Level 🗖 TOC						
	S		Bore Hole Diameter: in. to					and <u>Source</u> : Land Survey GPS To							
1 r	nile		in. to												
7 WELL WATER TO BE USED AS:															
1. Domestic:       5. <ul> <li>Public Water Supply: well ID</li> </ul>															
			6. Dewatering: how many wells?						est Hole: well ID						
			<ul> <li>7. Aquifer Recharge: well ID</li> <li>8. Monitoring: well ID</li> </ul>												
2. [] Irrigation     9. Environmental Remedia							<ul><li>12. Geothermal: how many bores?</li><li>a) Closed Loop ☐ Horizontal ☐ Vertical</li></ul>								
3. $\square$ Feedlo		Soil Vapor			b) Open Loop 🗌 Surface Discharge 🔲 In										
4. Industrial Recovery					Injection			13. Other (specify):							
Was a che	mical/bacte	riological sar	nple subn	nitted to K	DHE?	Yes 🗌	No	If yes, date	e sam	ple was submitte	d:				
Water well	disinfected	? 🗌 Yes 🔲	No					-		-					
										Glued 🗌 Clamped			☐ Threaded		
										in. to					
					.t	lb:	s./ft.	Wall thick	cness	or gauge No	•••••	••			
$\square$ Steel		R PERFORA			$\Box$ PVC				or (S	pecify)					
		vanized Steel	☐ Fibeı ☐ Conc		$\square$ None	used (one	n hole)			pecify)		• • • • • •			
		RATION OPE				usea (ope	ii iioie)								
🗌 Contin	uous Slot	☐ Mill Slot	🗆 G	auze Wrapp	ed 🗌 T	orch Cut	🗌 Dr	illed Holes		Other (Specify)					
		🗌 Key Puncl	hed 🗌 W	vire Wrappe	d 🗌 S	aw Cut	🗌 No	one (Open H	Iole)						
										ft., From					
										ft., From					
										£ 4-					
		ole contaminati		It., From .	•••••	. It. to	•••••	It., From	•••••	ft. to	It.				
□ Septic	Tank		Lateral Line	es 🗆	Pit Privy		ΠI	Livestock Pe	ens	Insectio	ide Stora	ige			
Sewer 1	Lines		Cess Pool		Sewage L	agoon	ΠF	Fuel Storage		Abando			ell		
□ Watert	ight Sewer Li	ines 🔲 S	Seepage Pit		Feedyard		🗆 F	Fertilizer Sto	orage	🗌 Oil We	ll/Gas W	ell			
Sewer Lines       Cess Pool       Sewage Lagoon       Fuel Storage       Abandoned Water Well         Watertight Sewer Lines       Seepage Pit       Feedyard       Fertilizer Storage       Oil Well/Gas Well         Other (Specify)       Direction from well?       Distance from well?       ft.															
10 FROM	TO		ITHOLO		ince from v	FRC		ТО	 I ITL	ft. HO. LOG (cont.) or	DILICC	INC	INTEDVALS		
IU FROM	10	1		GIC LUG		FRU	IVI	10	LIII	10. LOG (colit.) of	FLUUU	INU	INTERVALS		
	Notes:														
11 CONT	RACTOR	S OR LAND	WNFR'	S CERTIE	TCATIO	N. This	water	well was [		nstructed, 🗌 reco	nstructo	d or	nlugged		
under my jurisdiction and was completed on (mo-day-year) and this record is true to the best of my knowledge and belief. Kansas Water Well Contractor's License No This Water Well Record was completed on (mo-day-year)															
under the b	usiness nam	<u>ne of</u>	117 A DED				<u></u>	1 1 1 1 1 1 1 1 1		1 4 4 1					
KS Departr	nent of Health									r each <u>constructed</u> we a, Kansas 66612-136		one 7	85-296-3565		
-		eks.gov/waterwel		, _00108				,	- r - r				82a-1212		

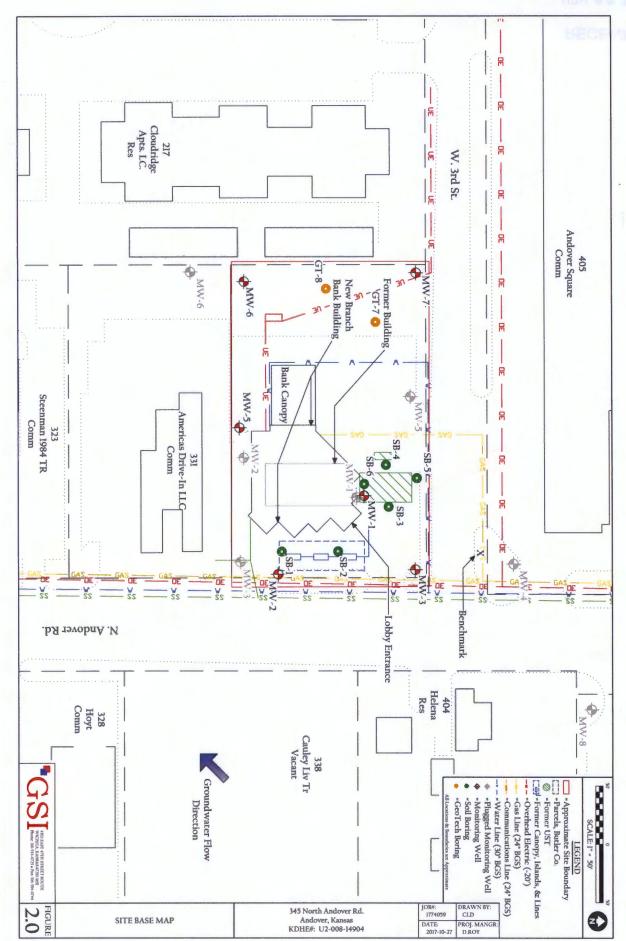

104 3 9