


☐ Original Record ☐ Correction ☐ Change in Well Use

[illegible]

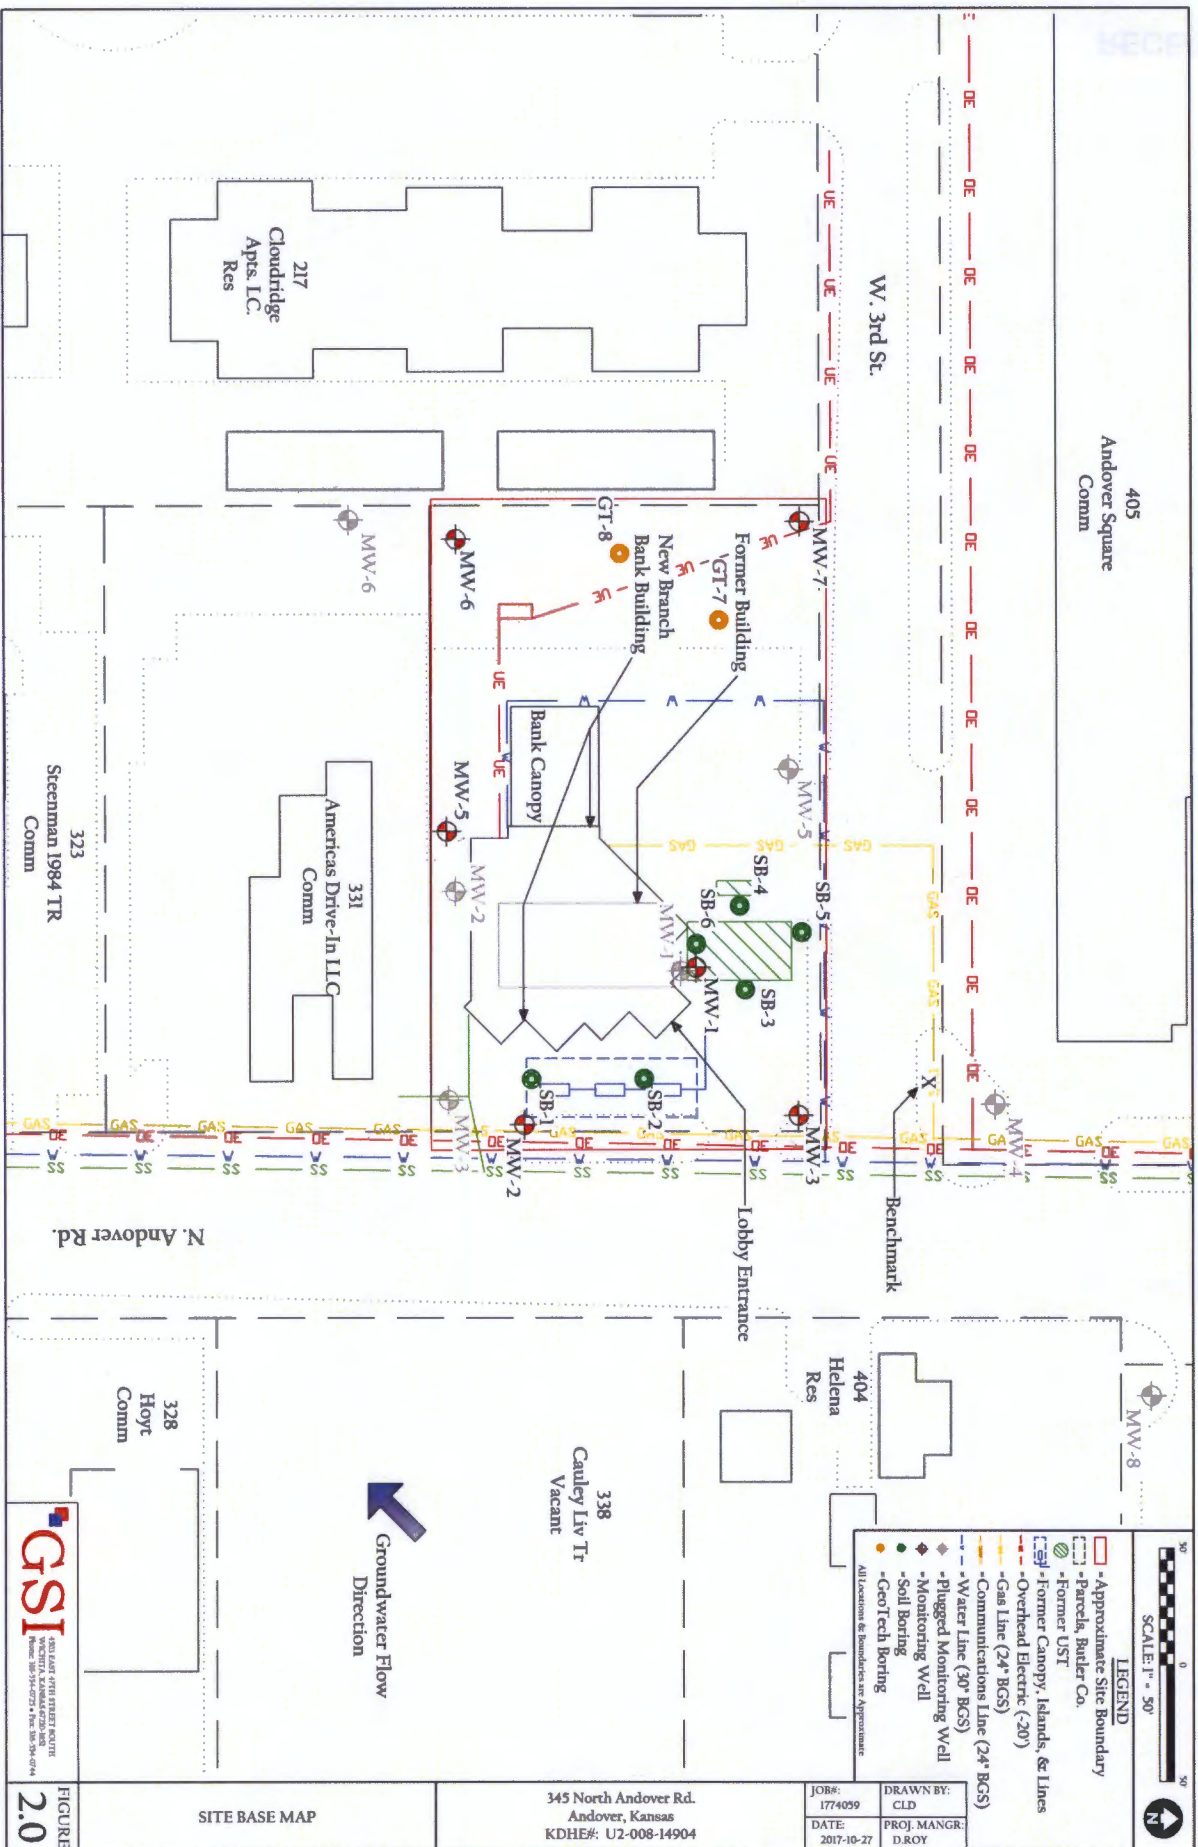

GSI

FIGURE 2.0

SITE BASE MAP

345 North Andover Rd.
 Andover, Kansas
 KDHE#: U2-008-14904

JOB#: 1774059
 DATE: 2017-10-27

DRAWN BY: CLD
 PROJ. MANGR: D.ROY