

USE TYPEWRITER OR BALL
POINT PEN-PRESS FIRMLY,
PRINT CLEARLY.

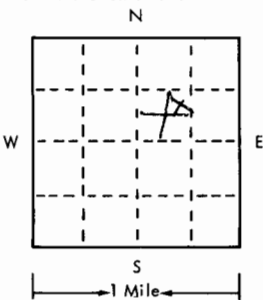
WATER WELL RECORD
KSA 82a-1201-1215

T R EW sec 1/4 1/4 1/4 No.

Kansas State Dept. Of Health
(Water Well Contractors)
Forbes-Bldg. 740
Topeka, Kansas 66620

1 Location of well:	County <u>Butler</u>	Township name <u>N 34 W 4 N</u>	Fraction <u>NE SW 1/4 E</u>	Section number <u>1</u>	Town number <u>278</u>	Range number <u>3 E</u>
---------------------	-------------------------	------------------------------------	--------------------------------	----------------------------	---------------------------	----------------------------

Distance and direction from nearest town or city: <u>3 W 4 N of Augusta Kan</u>	3 Owner of well: <u>Windermer Farms</u>
Street address of well location if in city:	Address: <u>PO Box 52 Towanda</u>

Locate with "X" in section below: 	Sketch map:	4 Well depth: <u>120</u> ft. Date of completion <u>8/11/80</u> Well diameter <u>8</u> in.
--	-------------	--

2	Type and color of material	From	To	6	<input checked="" type="checkbox"/> Cable tool <input type="checkbox"/> Rotary <input type="checkbox"/> Driven <input type="checkbox"/> Dug <input type="checkbox"/> Hollow rod <input type="checkbox"/> Jetted <input type="checkbox"/> Bored <input type="checkbox"/> Reverse rotary
	<u>Soil</u>	<u>0</u>	<u>2</u>	6 Use: <input checked="" type="checkbox"/> Domestic <input type="checkbox"/> Public supply <input type="checkbox"/> Industry <input type="checkbox"/> Irrigation <input type="checkbox"/> Air conditioning <input type="checkbox"/> Commercial <input type="checkbox"/> Test well	
	<u>Rock</u>	<u>2</u>	<u>25</u>	7 Casing: Material <u>PLS</u> Height: above/below Threaded <input type="checkbox"/> Welded <input type="checkbox"/> Surface <u>18</u> in. Diam. <u>929</u> Weight <u>200</u> lbs./ft. <u>5</u> in. to <u>120</u> ft. depth Drive shoe? <input type="checkbox"/> Yes <input type="checkbox"/> No <u>1214</u>	
	<u>SHale</u>	<u>25</u>	<u>32</u>	8 Screen: <u>Sun Flower</u> Manufacturer <u>Sun Flower</u> Type <u>200</u> Dia. <u>5</u> Slot/gauze <u>1/16</u> Length <u>20</u> Set between <u>55</u> ft. and <u>75</u> ft. Fittings: Gravel pack <input type="checkbox"/> Yes <input checked="" type="checkbox"/> No Size range of material	
	<u>Lime</u>	<u>32</u>	<u>40</u>	9 Static water level: <u>50</u> ft. below land surface Date <u>5/11/80</u>	
	<u>SHale & Lime</u>	<u>40</u>	<u>55</u>	10 Pumping level below land surfaces: <u>60</u> ft. after <u>1</u> hrs. pumping <u>36</u> g.p.m. <u>30</u> ft. after <u>1</u> hrs. pumping <u>36</u> g.p.m. Estimated maximum yield <u>30</u> g.p.m.	
	<u>water Lime</u>	<u>55</u>	<u>85</u>	11 Water sample submitted: <input type="checkbox"/> Yes <input checked="" type="checkbox"/> No Date	
	<u>SHale</u>	<u>85</u>	<u>120</u>	12 Well head completion: <input type="checkbox"/> Pitless adapter <input type="checkbox"/> Inches above grade	
				13 Well grouted? <input checked="" type="checkbox"/> Yes <input type="checkbox"/> No <input checked="" type="checkbox"/> Neat cement <input type="checkbox"/> Bentonite <input type="checkbox"/> Depth: From <u>0</u> ft. to <u>10</u> ft.	
				14 Nearest source of possible contamination: ft. <u>150</u> Direction <u>E</u> Type <u>Logan</u> Well disinfected upon completion? <input type="checkbox"/> Yes <input type="checkbox"/> No	
				15 Pump: <input checked="" type="checkbox"/> Not installed Manufacturer's name Model number HP Volts Length of drop pipe ft. capacity g.p.m. Type: <input type="checkbox"/> Submersible <input type="checkbox"/> Turbine <input type="checkbox"/> Jet <input type="checkbox"/> Reciprocating <input type="checkbox"/> Centrifugal <input type="checkbox"/> Other	

16 Remarks: elevation	17 Water well contractor's certification: This well was drilled under my jurisdiction and this report is true to the best of my knowledge and belief. <u>Winter Well Drill 251</u> Business name <u>PO Box 30 Augusta Kan</u> License No. Address <u>PO Box 30 Augusta Kan</u> Signed <u>Charles W. Windermer</u> Date <u>9/8/80</u> Authorized representative
-----------------------	--

Topography:
☐ Hill
☐ Slope
☒ Upland
☐ Valley