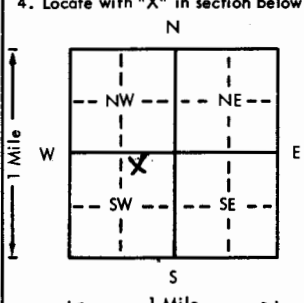


USE TYPEWRITER OR BALL
POINT PEN-PRESS FIRMLY,
PRINT CLEARLY.

WATER WELL RECORD
KSA 82a-1201-1215

Kansas Department of Health and
Environment-Division of Environment
(Water well Contractors)
Topeka, Kansas 66620

1. Location of well:	County <u>Butler</u>	Fraction <u>NW 1/4 NE 1/4 SW 1/4</u>	Section number <u>1</u>	Township number <u>T 27 S</u>	Range number <u>R 3 E</u>
2. Distance and direction from nearest town or city:	<u>4 W 4 N</u>	3. Owner of well:	<u>Grige Cooley</u>		
Street address of well location if in city:	<u>of Augusta</u>	R.R. or street:	<u>Rt Augusta</u>		
4. Locate with "X" in section below:	Sketch map:		6. Bore hole dia. <u>9</u> in. Completion date <u>10/2/79</u>		
			Well depth <u>100</u> ft.		
			7. ☒ Cable tool ☐ Rotary ☐ Driven ☐ Dug ☐ Hollow rod ☐ Jetted ☐ Bored ☐ Reverse rotary		
5. Type and color of material	From	To	8. Use: ☒ Domestic ☐ Public supply ☐ Industry ☐ Irrigation ☐ Air conditioning ☐ Stock ☐ Lawn ☐ Oil field water ☐ Other		
<u>Soil</u>	<u>0</u>	<u>4</u>	9. Casing: Material <u>5</u> Height <u>Above</u> or below		
<u>Rock</u>	<u>4</u>	<u>20</u>	Threaded <u>Welded</u> Surface <u>78</u> in.		
<u>Clay</u>	<u>20</u>	<u>45</u>	RMP <u>X</u> PVC Weight <u>100</u> lbs./ft.		
<u>where did the groundwater shale</u>	<u>45</u>	<u>60</u>	Dia. <u>5</u> in. to <u>100</u> ft. depth Wall Thickness: inches or		
<u>come in at? Water</u>	<u>60</u>	<u>85</u>	Dia. <u>5</u> in. to <u>100</u> ft. depth gage No. <u>115</u>		
<u>shale</u>	<u>85</u>	<u>100</u>	10. Screen: Manufacturer's name <u>SanFlow</u>		
			Type <u>100</u> Dia. <u>5</u>		
			Slot/gauze <u>1/16</u> Length <u>30</u>		
			Set between <u>60</u> ft. and <u>80</u> ft.		
			Gravel pack? <u>Yes</u> Size range of material <u>5/8</u>		
			11. Static water level: <u>50</u> ft. below land surface Date <u>10/2/79</u>		
			12. Pumping level below land surfaces: <u>Bailing</u>		
			<u>50</u> ft. after <u>60</u> hrs. pumping <u>200</u> g.p.m.		
			Estimated maximum yield <u>200</u> g.p.m.		
			13. Water sample submitted: <u>Yes</u> No Date		
			14. Well head completion: <u>18</u> inches above grade		
			15. Well grouted? <u>Yes</u>		
			With: ☒ Neat cement ☐ Bentonite ☐ Concrete		
			Depth: From <u>0</u> ft. to <u>10</u> ft.		
			16. Nearest source of possible contamination: <u>Septic</u>		
			ft. <u>120</u> Direction <u>SE</u> Type <u>Septic</u>		
			Well disinfected upon completion? ☒ Yes ☐ No		
			17. Pump: ☒ Not installed		
			Manufacturer's name		
			Model number HP Volts		
			Length of drop pipe ft. capacity g.p.m.		
			Type:		
			☐ Submersible ☐ Turbine		
			☐ Jet ☐ Reciprocating		
			☐ Centrifugal ☐ Other		
18. Elevation:	19. Remarks:		20. Water well contractor's certification:		
Topography:	<u>Owner To install</u>		This well was drilled under my jurisdiction and this report		
☐ Hill	<u>Concrete Slab around</u>		is true to the best of my knowledge and belief. <u>250</u>		
☐ Slope	<u>signature.</u>		Business name <u>Water Well Drilling</u> License No.		
☒ Upland	<u>Signature on File</u>		Address <u>P2 Box 30 Augusta</u>		
☐ Valley			Signed <u>Charles Winters</u> Date <u>10/2/79</u>		

Forward the white, blue and pink copies to the Department of Health and Environment

Form WWC-5