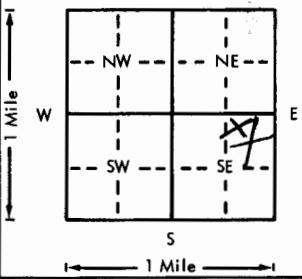


USE TYPEWRITER OR BALL
POINT PEN-PRESS FIRMLY,
PRINT CLEARLY.

WATER WELL RECORD
KSA 82a-1201-1215

Kansas Department of Health and
Environment-Division of Environment
(Water well Contractors)
Topeka, Kansas 66620

1. Location of well:	County Batler	Fraction W 1/4 NE 1/4 SE 1/4	Section number 1	Township number T 27 S R 3	Range number EM	
2. Distance and direction from nearest town or city:	SW 4N		3. Owner of well:	Larry Watkins		
Street address of well location if in city:	OF Augusta		R.R. or street:	R 4 Avenue S		
4. Locate with "X" in section below:			Sketch map:	House well Septic slop		
5. Type and color of material	From	To	Soil 0 4 Rock 4 20 Clay 20 45 Shale 45 60 Water Line 60 85 Shale 85 100			
6. Bore hole dia. 8 in. Completion date 3/5/77	Well depth 100 ft.					
7. <input checked="" type="checkbox"/> Cable tool <input type="checkbox"/> Rotary <input type="checkbox"/> Driven <input type="checkbox"/> Dug <input type="checkbox"/> Hollow rod <input type="checkbox"/> Jetted <input type="checkbox"/> Bored <input type="checkbox"/> Reverse rotary						
8. Use: <input checked="" type="checkbox"/> Domestic <input type="checkbox"/> Public supply <input type="checkbox"/> Industry <input type="checkbox"/> Irrigation <input type="checkbox"/> Air conditioning <input type="checkbox"/> Stock <input type="checkbox"/> Lawn <input type="checkbox"/> Oil field water <input type="checkbox"/> Other						
9. Casing: Material PS Height: Above or below Threaded <input type="checkbox"/> Welded 18 in. RMP X PVC Weight 100 lbs./ft. Dia. 5 in. to 100 ft. depth Wall Thickness: inches or Dia. — in. to — ft. depth Gage No. 175						
10. Screen: Manufacturer's name San Flower						
Type 100 Dia. 20 Slot/gauze 1/16 Length 20 Set between 75 ft. and 95 ft. ft. and — ft. Gravel pack? Yes Size range of material. 5/8						
11. Static water level: 50 ft. below land surface Date 3/5/77 mo./day/yr.						
12. Pumping level below land surfaces: 55 ft. after 1 hrs. pumping g.p.m. ft. after — hrs. pumping g.p.m. Estimated maximum yield 30 g.p.m.						
13. Water sample submitted: Yes <input checked="" type="checkbox"/> No <input type="checkbox"/> Date —						
14. Well head completion: Pitless adapter Inches above grade						
15. Well grouted? Yes With: <input checked="" type="checkbox"/> Neat cement <input type="checkbox"/> Bentonite <input checked="" type="checkbox"/> Concrete Depth: From 0 ft. to 10 ft.						
16. Nearest source of possible contamination: ft. 150 Direction SW Type Septic						
17. Pump: Manufacturer's name Winter Well Drill 251 Not installed Model number 82 Box 30 HP — Volts — Length of drop pipe — ft. capacity — g.p.m. Type: <input type="checkbox"/> Submersible <input type="checkbox"/> Turbine <input type="checkbox"/> Jet <input type="checkbox"/> Reciprocating <input type="checkbox"/> Centrifugal <input type="checkbox"/> Other						
18. Elevation: Topography: <input type="checkbox"/> Hill <input type="checkbox"/> Slope <input checked="" type="checkbox"/> Upland <input type="checkbox"/> Valley	19. Remarks: Owner To Install Concrete Slab around Well Head		Winter Well Drill 251 Business name 82 Box 30 License No. Address — Signed Charles Whistler Date 3/7/77 Authorized representative			