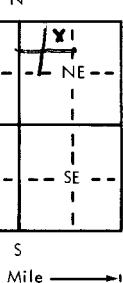
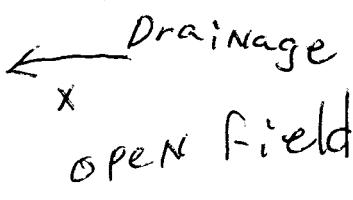


1. Location of well:	County Butler	Fraction NE 1/4 NW 1/4 NE 1/4	Section number 1	Township number T 27 S 3	Range number E 6	
2. Distance and direction from nearest town or city:	SW 4N 4W OF AUGUSTA		3. Owner of well: H. B. Bartleson			
Street address of well location if in city:			R.R. or street: RT BOX 147F			
City, state, zip code: AUGUSTA KS 67013						
4. Locate with "X" in section below:			Sketch map: 			
5. Type and color of material	From	To	6. Bore hole dia. 5 1/2 in. Completion date 6-6-71 Well depth 95 ft.			
Top Soil	0	1				
Clay Redish brown	1	4				
Clay yellow	4	10				
Limestone yellow	10	18				
Shale gray green	18	34				
Clay yellow	34	73				
Limestone yellow	73	83				
Shale blue gray	83	95				
(Water at 76')						
(Use a second sheet if needed)						
18. Elevation:	19. Remarks: Basement grage will be constructed around well with cement floor					20. Water well contractor's certification: This well was drilled under my jurisdiction and this report is true to the best of my knowledge and belief. Braddy water wells 363
Topography: <input checked="" type="checkbox"/> Hill <input checked="" type="checkbox"/> Slope <input type="checkbox"/> Upland <input type="checkbox"/> Valley						Business name R 2 Douglass KS Address Signed Authorized representative
						License No. 66-1