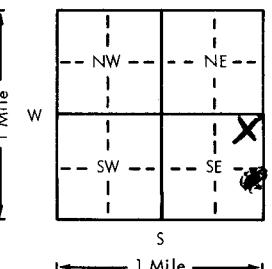
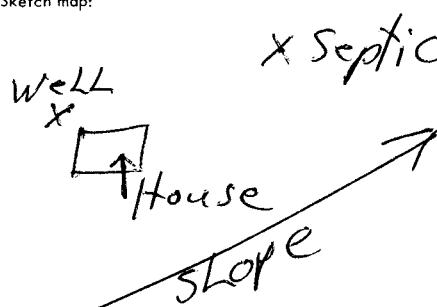


1. Location of well:	County Butler	Fraction NE 1/4 NE 1/4 SE 1/4	Section number 8	Township number T 29	Range number S 3	E/W
2. Distance and direction from nearest town or city:	1/2 East Andover		3. Owner of well: Greg Mayfield			
Street address of well location if in city:			R.R. or street: 321 E Meads			
X Locate with "X" in section below:		Sketch map:				
						
5. Type and color of material		From	To			
	Top Soil	0	3			
	Clay - Red	3	8			
	Clay - Yellow	8	15			
	Rock	15	25			
	Shale	25	40			
	Sandy Lime	40	60			
	Shale	60	80			
(Use a second sheet if needed)						
18. Elevation:	19. Remarks: Owner to install Cement Slab around Well Head			20. Water well contractor's certification: This well was drilled under my jurisdiction and this report is true to the best of my knowledge and belief. 251 Winter Well Drilling Business name Box 30 Augusta License No. 141 Address Charles Weller Date 8/11 Signed Charles Weller Authorized representative		
Topography:	Hill	Slope	Upland	Valley		