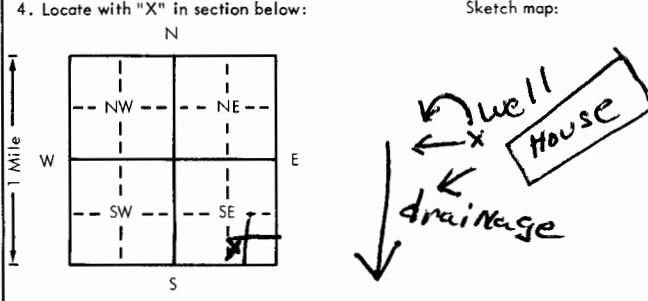


1. Location of well:	County Butler	Fraction SW 1/4 SE 1/4 SE 1/4	Section number 9	Township number T 27	Range number S R 3
2. Distance and direction from nearest town or city: Street address of well location if in city:	1 3/4 Miles East OF ANDOVER		3. Owner of well: R.R. or street: City, state, zip code:	JOHN Harpstrite 1333 Tavern ANDOVER KS 67002	
4. Locate with "X" in section below:	Sketch map: 		X 6. Bore hole dia. 8 1/2 in. Completion date _____ Well depth 70 ft. _____		
5. Type and color of material	From	To	7. X Cable tool Rotary Driven Dug Hollow rod Jetted Bored Reverse rotary	8. Use: X Domestic Public supply Industry Irrigation Air conditioning Stock Lawn Oil field water Other	
6. Type and color of material	From	To	9. Casing: Material PITS Height 12 above or below Threaded glue Surface 12 in. RMP X PVC Weight 200 lbs./ft. Dia. 5 in. to 70 ft. depth Wall Thickness: inches or Dia. 5 in. to ft. depth gage No. 200	10. Screen: Manufacturer's name SUNflower MFD INC Type RMP Dia. 5" Slot/gauze 1/16 Length 10' Set between 60 ft. and 70 ft. ft. and ft. Gravel pack? yes Size range of material 1/2 to 1/4	
7. Type and color of material	From	To	11. Static water level: 27 ft. below land surface Date 8-9-78	12. Pumping level below land surfaces: NA ft. after hrs. pumping g.p.m. ft. after hrs. pumping g.p.m. Estimated maximum yield g.p.m.	
8. Type and color of material	From	To	13. Water sample submitted: Yes X No Date _____	14. Well head completion: X Pitless adapter 12 Inches above grade	
9. Type and color of material	From	To	15. Well grouted? yes With: Neat cement X Bentonite X Concrete Depth: From 13 ft. to 3 ft.	16. Nearest source of possible contamination: NA ft. Direction Type Well disinfected upon completion? X Yes No	
10. Type and color of material	From	To	17. Pump: X Not installed Manufacturer's name _____ Model number _____ HP _____ Volts _____ Length of drop pipe _____ ft. capacity _____ g.p.m. Type: Submersible Turbine Jet Reciprocating Centrifugal Other	18. Elevation: Topography: Hill X Slope Upland Valley	
11. Remarks: OWNER WILL INSTALL CONCRETE SLAB	(Use a second sheet if needed)		19. Remarks: OWNER WILL INSTALL CONCRETE SLAB	20. Water well contractor's certification: This well was drilled under my jurisdiction and this report is true to the best of my knowledge and belief. Braddy Water Wells 363 Business name Braddy Water Wells 363 License No. 119-18 Address Box 717A Douglas Signed Richard Braddy Date 11-9-78 Authorized representative	