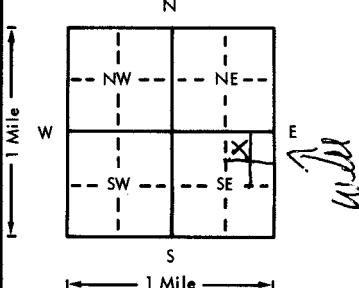
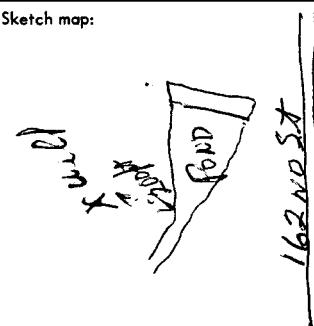


1. Location of well:	County BUTLER	Fraction NW 1/4 NE 1/4 SE 1/4	Section number 9	Township number T 27S	Range number S R 3E	Range number E/W	
2. Distance and direction from nearest town or city: 2 MILE EAST, 3/4 MI NORTH on West side of ROAD OFF OF 13th Street	Street address of well location if in city:		3. Owner of well: Les HARPS TRITE R.R. or street: 162 98 E 13th City, state, zip code: LAWRENCE, KANSAS				
4. Locate with "X" in section below:		Sketch map:	6. Bore hole dia. 8 in. Completion date 11-13-75 Well depth 63 ft.				
			7. <input checked="" type="checkbox"/> Cable tool <input type="checkbox"/> Rotary <input type="checkbox"/> Driven <input type="checkbox"/> Dug <input type="checkbox"/> Hollow rod <input type="checkbox"/> Jetted <input type="checkbox"/> Bored <input type="checkbox"/> Reverse rotary				
			8. Use: <input checked="" type="checkbox"/> Domestic <input type="checkbox"/> Public supply <input type="checkbox"/> Industry <input type="checkbox"/> Irrigation <input type="checkbox"/> Air conditioning <input type="checkbox"/> Stock <input type="checkbox"/> Lawn <input type="checkbox"/> Oil field water <input type="checkbox"/> Other				
			9. Casing: Material Plastic Height: Above or below Threaded <input type="checkbox"/> Welded <input type="checkbox"/> Surface 16 in. RMP 6 in. to 43 ft. depth Wall thickness: inches or Dia. 6 in. to ft. ft. depth gage No. 10				
5. Type and color of material		From	To	10. Screen: Manufacturer's name SUNFLOWER PLASTIC Type RMP Dia. 6" <input checked="" type="checkbox"/> Slot gauge 1/4" Drilled Length 20 ft Set between 43 ft. and 63 ft. Gravel pack? <input checked="" type="checkbox"/> Size range of material 3/8" to 1" gravel			
Brown Surface Gumbo Yellow Clay Water Shale (light Gray) Gray Clay Limestone Rock Water Shale Dark Gray Clay		0	8				
		8	46				
		46	48				
		48	54				
		54	56				
		56	58				
		58	63				
No source of contamination at this type. Customer is planning to build home here later							
(Use a second sheet if needed)							
18. Elevation:	19. Remarks:						
Topography:	Customer knows requirements of 4 ft x 4 ft Concrete Slab Les Harps Trite						
<input type="checkbox"/> Hill <input checked="" type="checkbox"/> Slope <input type="checkbox"/> Upland <input type="checkbox"/> Valley	20. Water well contractor's certification: This well was drilled under my jurisdiction and this report is true to the best of my knowledge and belief. Simmons DRILLING 163 Business name 163 Central LANDOWNER'S License No. Address 163 Central LANDOWNER'S Signed Ben Brueggen Date 11-13-75 Authorized representative						