

1 LOCATION OF WATER WELL:		Fraction		Section Number		Township Number		Range Number	
County:	Butler	NW ¼	NW ¼	NE ¼	9	T 27 S	R 3E	E/W	


Distance and direction from nearest town or city street address of well if located within city?

16256 E. 13th N. Butler County

2 WATER WELL OWNER: Carney, Tim  
RR#, St. Address, Box # : 255 S. Cardinal Lane  
City, State, ZIP Code : Wichita, Kansas 67230

Board of Agriculture, Division of Water Resources  
Application Number:

3 LOCATE WELL'S LOCATION WITH AN "X" IN SECTION BOX: 4 DEPTH OF COMPLETED WELL..... 105... ft. ELEVATION: .....

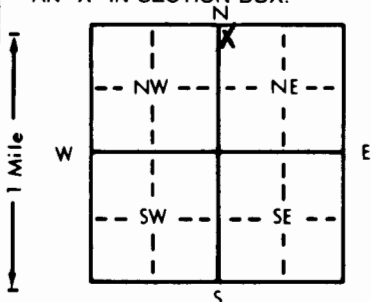

4 DEPTH OF COMPLETED WELL ..... 105 ..... ft. ELEVATION: .....  
 Depth(s) Groundwater Encountered 1. .... ft. 2. .... ft. 3. .... ft.  
 WELL'S STATIC WATER LEVEL ..... 30 ..... ft. below land surface measured on mo/day/yr ..... 4-8-92  
 Pump test data: Well water was ..... ft. after ..... hours pumping ..... gpm  
 Est. Yield ..... 3 ..... gpm: Well water was ..... ft. after ..... hours pumping ..... gpm  
 Bore Hole Diameter ..... 12 in. to ..... 105 ..... ft., and ..... in. to ..... ft.  
 WELL WATER TO BE USED AS: 5 Public water supply 8 Air conditioning 11 Injection well  
 1 Domestic 3 Feedlot 6 Oil field water supply 9 Dewatering 12 Other (Specify below)  
 2 Irrigation 4 Industrial 7 Lawn and garden only 10 Monitoring well  
 Was a chemical/bacteriological sample submitted to Department? Yes ..... No ..... X; If yes, mo/day/yr sample was sub-  
 mitted Water Well Disinfected? Yes X No

5 TYPE OF BLANK CASING USED:		3 Wrought iron	8 Concrete tile	CASING JOINTS: Glued . . . <input checked="" type="checkbox"/> Clamped . . . .	
1 Steel	3 RMP (SR)	6 Asbestos-Cement	9 Other (specify below)	Welded . . . . .	
2 PVC	4 ABS	7 Fiberglass	SDR-26	Threaded . . . . .	
Blank casing diameter . . . . . 5 in. to . . . . . 35 ft., Dia . . . . .		in. to . . . . . ft., Dia . . . . .		in. to . . . . . ft.	
Casing height above land surface . . . . . 12 in., weight . . . . . 2.29		lbs./ft. Wall thickness or gauge No. . . . . 214			
TYPE OF SCREEN OR PERFORATION MATERIAL:					
1 Steel	3 Stainless steel	5 Fiberglass	7 PVC	10 Asbestos-cement	
2 Brass	4 Galvanized steel	6 Concrete tile	8 RMP (SR)	11 Other (specify) . . . . .	
			9 ABS	12 None used (open hole)	
SCREEN OR PERFORATION OPENINGS ARE:					
1 Continuous slot	3 Mill slot	5 Gauzed wrapped	8 Saw cut	11 None (open hole)	
2 Louvered shutter	4 Key punched	6 Wire wrapped	9 Drilled holes		
		7 Torch cut	10 Other (specify) . . . . .		
SCREEN-PERFORATED INTERVALS:					
From . . . . . 35		ft. to . . . . . 105		ft. From . . . . . ft. to . . . . . ft.	
From . . . . .		ft. to . . . . .		ft. From . . . . . ft. to . . . . . ft.	
GRAVEL PACK INTERVALS:					
From . . . . . 24		ft. to . . . . . 105		ft. From . . . . . ft. to . . . . . ft.	
From . . . . .		ft. to . . . . .		ft. From . . . . . ft. to . . . . . ft.	

6 GROUT MATERIAL:		1 Neat cement	2 Cement grout	3 Bentonite	4 Other
Grout Intervals:		From 4 ft. to 24 ft.	From	ft. to	ft. to
What is the nearest source of possible contamination:			10 Livestock pens		
1 Septic tank	4 Lateral lines	7 Pit privy	11 Fuel storage	14 Abandoned water well	
2 Sewer lines	5 Cess pool	8 Sewage lagoon	12 Fertilizer storage	15 Oil well/Gas well	
3 Watertight sewer lines	6 Seepage pit	9 Feedyard	13 Insecticide storage	16 Other (specify below)	
Direction from well?			None Apparent		
			How many feet?		

[illegible]

7 CONTRACTOR'S OR LANDOWNER'S CERTIFICATION: This water well was (1) constructed, (2) reconstructed, or (3) plugged under my jurisdiction and was completed on (mo/day/year) 4-8-92 and this record is true to the best of my knowledge and belief. Kansas Water Well Contractor's License No. 236 This Water Well Record was completed on (mo/day/yr) 5-31-92 under the business name of Harp Well and Pump Service, Inc. by (signature) Mary Arnold