

WATER WELL RECORD Form WWC-5 KSA 82a-1212


1 LOCATION OF WATER WELL:	Fraction County: Butler NE $\frac{1}{4}$ Nw $\frac{1}{4}$ Ne $\frac{1}{4}$	Section Number 11	Township Number T 27 S	Range Number R 3 E E/W
---------------------------	--	----------------------	---------------------------	---------------------------

Distance and direction from nearest town or city street address of well if located within city?

#5 Bittersweet 3½ East of Andover Road on 21st then So. Andover Road

2 WATER WELL OWNER:	MA. Hubbart RR#, St. Address, Box # : 1601 Womer City, State, ZIP Code : Wichita, Kansas	Board of Agriculture, Division of Water Resources Application Number:
---------------------	--	--

3 LOCATE WELL'S LOCATION WITH AN "X" IN SECTION BOX:	4 DEPTH OF COMPLETED WELL: 65 ft. ELEVATION: Depth(s) Groundwater Encountered 1. 12 ft. 2. ft. 3. ft.
--	--

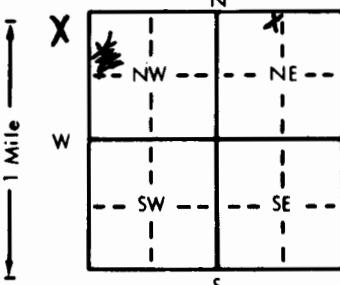

WELL'S STATIC WATER LEVEL: 12 ft. below land surface measured on mo/day/yr 10-18-84.
--

Pump test data: Well water was ft. after hours pumping gpm
--

Est. Yield gpm: Well water was ft. after hours pumping gpm
--

Bore Hole Diameter: 11 in. to 65 ft., and in. to ft.
--

WELL WATER TO BE USED AS: 5 Public water supply 8 Air conditioning 11 Injection well
--

① Domestic 3 Feedlot 6 Oil field water supply 9 Dewatering 12 Other (Specify below)

2 Irrigation 4 Industrial 7 Lawn and garden only 10 Observation well
--

Was a chemical/bacteriological sample submitted to Department? Yes No XX If yes, mo/day/yr sample was submitted

Water Well Disinfected? Yes X No

5 TYPE OF BLANK CASING USED: 1 Steel 2 PVC =3 BMP (SR) 4 ABS	5 Wrought iron 6 Asbestos-Cement 7 Fiberglass	8 Concrete tile 9 Other (specify below) Cer-Mac Styrene SDR-26	CASING JOINTS: Glued XX Clamped Welded Threaded
--	---	--	---

Blank casing diameter: 5 in. to 25 ft., Dia. in. to ft., Dia. in. to ft.
--

Casing height above land surface: 12 in., weight: 1.59 lbs./ft. Wall thickness or gauge No. 203

TYPE OF SCREEN OR PERFORATION MATERIAL: 1 Steel 2 Brass 3 Stainless steel 4 Galvanized steel	5 Fiberglass 6 Concrete tile	7 PVC 8 RMP (SR) =9 ABS ==	10 Asbestos-cement 11 Other (specify) 12 None used (open hole)
--	------------------------------	----------------------------	--

SCREEN OR PERFORATION OPENINGS ARE: 1 Continuous slot 2 Louvered shutter 3 Mill slot 4 Key punched	5 Gauzed wrapped 6 Wire wrapped 7 Torch cut	8 Saw cut 9 Drilled holes 10 Other (specify)	11 None (open hole)
--	---	--	---------------------

SCREEN-PERFORATED INTERVALS: From: 25 ft. to 65 ft., From: ft. to ft.

From: ft. to ft., From: ft. to ft.
--

GRAVEL PACK INTERVALS: From: 14 ft. to 65 ft., From: ft. to ft., From: ft. to ft.

From: ft. to ft., From: ft. to ft.
--

6 GROUT MATERIAL: 1 Neat cement 2 Cement grout 3 Bentonite 4 Other
--

Grout Intervals: From: 4 ft. to 14 ft., From: ft. to ft., From: ft. to ft., From: ft. to ft.
--

What is the nearest source of possible contamination: 1 Septic tank 2 Sewer lines 3 Watertight sewer lines 4 Lateral lines 5 Cess pool 6 Seepage pit
--

7 Pit privy 8 Sewage lagoon 9 Feedyard
--

10 Livestock pens 11 Fuel storage 12 Fertilizer storage 13 Insecticide storage
--

14 Abandoned water well 15 Oil well/Gas well 16 Other (specify below) NONE APPARENT

Direction from well? WEST How many feet? 60

FROM TO LITHOLOGIC LOG

0 2 Topsoil

2 22 Soft Clay

22 65 Blue Shale

7 CONTRACTOR'S OR LANDOWNER'S CERTIFICATION: This water well was (1) constructed, (2) reconstructed, or (3) plugged under my jurisdiction and was completed on (mo/day/year) 10-18-84 and this record is true to the best of my knowledge and belief. Kansas
--

Water Well Contractor's License No. 236 This Water Well Record was completed on (mo/day/yr) 6-16-85

under the business name of Harp Well & Pump Service, Inc. by (signature) Mary Arnold
--

INSTRUCTIONS: Use typewriter or ball point pen, PLEASE PRESS FIRMLY and PRINT clearly. Please fill in blanks, underline or circle the correct answers. Send top three copies to Kansas Department of Health and Environment, Division of Environment, Environmental Geology Section, Topeka, KS 66620. Send one to WATER WELL OWNER and retain one for your records.
--