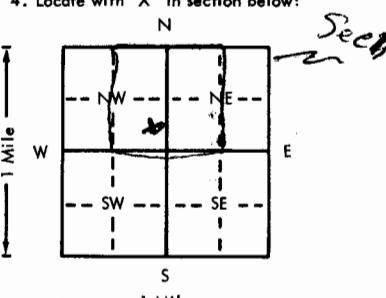


USE TYPEWRITER OR BALL
POINT PEN-PRESS FIRMLY,
PRINT CLEARLY.

WATER WELL RECORD
KSA 82a-1201-1215

Kansas Department of Health and
Environment-Division of Environment
(Water well Contractors)
Topeka, Kansas 66620

1. Location of well:	County Butler	Fraction CE 1/4 SE 1/4 NW 1/4	Section number 11	T 275	S 3	Range number (EW)	
2. Distance and direction from nearest town or city: 3 1/2	Street address of well location if in city: Andover	3. Owner of well: Charles Fisher					
		R.R. or street: R#1	City, state, zip code: Augusta Kans				
4. Locate with "X" in section below:		Sketch map:					6. Bore hole dia. 10 in. Completion date 8-30-1976 Well depth 90 ft.
							7. <input checked="" type="checkbox"/> Cable tool <input type="checkbox"/> Rotary <input type="checkbox"/> Driven <input type="checkbox"/> Dug <input type="checkbox"/> Hollow rod <input type="checkbox"/> Jetted <input type="checkbox"/> Bored <input type="checkbox"/> Reverse rotary
							8. Use: <input checked="" type="checkbox"/> Domestic <input type="checkbox"/> Public supply <input type="checkbox"/> Industry <input type="checkbox"/> Irrigation <input type="checkbox"/> Air conditioning <input type="checkbox"/> Stock <input type="checkbox"/> Lawn <input type="checkbox"/> Oil field water <input type="checkbox"/> Other
							9. Casing: Material plastic Height Above or below Threaded <input type="checkbox"/> Welded gl Surface 18 in. RMP X PVC Weight 175 lbs./ft. Dia. 6 in. to 90 ft. depth Wall Thickness: inches or Dia. 6 in. to 90 ft. depth gage No. 175
5. Type and color of material		From	To	10. Screen: Manufacturer's name gtl			
yellow lime		0	4	Type RMP Dia. 6 in Slat/gauze 1/4 ft. and 90 ft. Length 20' max			
yellow shale		4	17	Set between 1/4 ft. and 90 ft. ft. and 90 ft.			
grey shale		17	51	Gravel pack? no Size range of material 1/2			
Blue shale		51	57	11. Static water level: 53 ft. below land surface Date 8-30-1976 mo./day/yr.			
grey shale		57	62	12. Pumping level below land surfaces: ft. after 1 hrs. pumping 1 g.p.m. ft. after 1 hrs. pumping 1 g.p.m.			
grey lime		62	78	Estimated maximum yield 20 g.p.m.			
water		78		13. Water sample submitted: Yes <input checked="" type="checkbox"/> No <input type="checkbox"/> Date 8-30-1976 mo./day/yr.			
Blue shale		78	90	14. Well head completion: Pitless adapter 18 Inches above grade			
				15. Well grouted? yes With: <input checked="" type="checkbox"/> Neat cement <input type="checkbox"/> Bentonite <input type="checkbox"/> Concrete Depth: From 12 ft. to 0 ft.			
				16. Nearest source of possible contamination: ft. 150 Direction SW Type Septic Well disinfected upon completion? <input checked="" type="checkbox"/> Yes <input type="checkbox"/> No			
				17. Pump: <input checked="" type="checkbox"/> Not installed Manufacturer's name Wise well drilling Model number 122 HP 1 Volts 115 Length of drop pipe 10 ft. capacity 1 g.p.m. Type: <input type="checkbox"/> Submersible <input type="checkbox"/> Turbine <input type="checkbox"/> Jet <input type="checkbox"/> Reciprocating <input type="checkbox"/> Centrifugal <input type="checkbox"/> Other			
		(Use a second sheet if needed)					
18. Elevation:	19. Remarks: Owner well put on slab. CF Fisher						20. Water well contractor's certification: This well was drilled under my jurisdiction and this report is true to the best of my knowledge and belief. Wise well drilling 122 Business name Route 3, Box 1284 License No. Address Augusta KS Signed Murray Wate Date 8-30-1976 Authorized representative CF Fisher Date 8-30-1976
Topography: <input checked="" type="checkbox"/> Hill <input type="checkbox"/> Slope <input type="checkbox"/> Upland <input type="checkbox"/> Valley							