

## 1 LOCATION OF WATER WELL:

Fraction

1/4 NW 1/4 SW 1/4

Section Number

Township Number

Range Number

County: Butler

T 27 S

R 30 EW

Distance and direction from nearest town or city street address of well if located within city?

85 E 3 N of Augusta

Wichita Kan 67207

## 2 WATER WELL OWNER:

RR#, St. Address, Box #


City, State, ZIP Code

Bill Christie 8107 Peach Tree

Board of Agriculture, Division of Water Resources

Application Number:

## 3 LOCATE WELL'S LOCATION WITH AN "X" IN SECTION BOX:

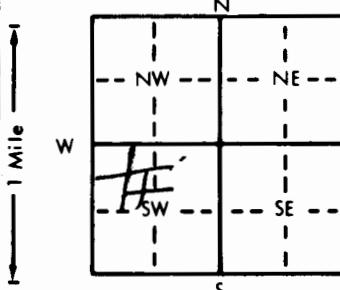

4 DEPTH OF COMPLETED WELL 105 ft. ELEVATION: .....

Depth(s) Groundwater Encountered 180 ft. 2. .... ft. 3. .... ft.

WELL'S STATIC WATER LEVEL 48 ft. below land surface measured on mo/day/yr

Pump test data: Well water was ..... ft. after ..... hours pumping ..... gpm

Est. Yield 35 gpm Well water was ..... ft. after ..... hours pumping ..... gpm

Bore Hole Diameter 8 in. to ..... ft., and ..... in. to ..... ft.

WELL WATER TO BE USED AS: 5 Public water supply 8 Air conditioning 11 Injection well

1 Domestic 3 Feedlot 6 Oil field water supply 9 Dewatering 12 Other (Specify below)

2 Irrigation 4 Industrial 7 Lawn and garden only 10 Monitoring well

Was a chemical/bacteriological sample submitted to Department? Yes ..... No ..... If yes, mo/day/yr sample was submitted

Water Well Disinfected? Yes ..... No

## 5 TYPE OF BLANK CASING USED:

1 Steel 3 RMP (SR)  
2 PVC 4 ABS

5 Wrought iron 8 Concrete tile

CASING JOINTS: Glued ..... Clamped .....

6 Asbestos-Cement

9 Other (specify below)

Welded .....

7 Fiberglass

Threaded .....

Blank casing diameter 5 in. to 70 ft. Dia ..... in. to ..... ft. Dia ..... in. to ..... ft.

Casing height above land surface 18 in., weight ..... 160 lbs./ft. Wall thickness or gauge No. 1214

## TYPE OF SCREEN OR PERFORATION MATERIAL:

1 Steel 3 Stainless steel  
2 Brass 4 Galvanized steel

5 Fiberglass

8 RMP (SR)

10 Asbestos-cement

6 Concrete tile

9 ABS

11 Other (specify) .....

12 None used (open hole)

## SCREEN OR PERFORATION OPENINGS ARE:

1 Continuous slot 3 Mill slot  
2 Louvered shutter 4 Key punched

5 Gauzed wrapped

11 None (open hole)

6 Wire wrapped

8 Saw cut

7 Torch cut

9 Drilled holes

SCREEN-PERFORATED INTERVALS: From ..... 70 ft. to ..... 105 ft. From ..... ft. to ..... ft.

10 Other (specify) .....

From ..... ft. to ..... ft. From ..... ft. to ..... ft.

GRAVEL PACK INTERVALS: From ..... ft. to ..... ft. From ..... ft. to ..... ft.

From ..... ft. to ..... ft. From ..... ft. to ..... ft.

6 GROUT MATERIAL: 1 Neat cement 2 Cement grout 3 Bentonite 4 Other .....

Grout Intervals: From ..... 0 ft. to ..... 20 ft. From ..... ft. to ..... ft. From ..... ft. to ..... ft.

10 Livestock pens 14 Abandoned water well

11 Fuel storage 15 Oil well/Gas well

12 Fertilizer storage 16 Other (specify below)

13 Insecticide storage

What is the nearest source of possible contamination: 1 Septic tank 4 Lateral lines 7 Pit privy

2 Sewer lines 5 Cess pool 8 Sewage lagoon

3 Watertight sewer lines 6 Seepage pit 9 Feedyard

10 Livestock pens

11 Fuel storage

12 Fertilizer storage

13 Insecticide storage

14 Abandoned water well

15 Oil well/Gas well

16 Other (specify below) .....

How many feet? 100

Direction from well? N

FROM TO LITHOLOGIC LOG FROM TO PLUGGING INTERVALS

0 4 70 80 L 10 105 105 S SHALE + LIME

7 CONTRACTOR'S OR LANDOWNER'S CERTIFICATION: This water well was (1) constructed, (2) reconstructed, or (3) plugged under my jurisdiction and was completed on (mo/day/year) 5/31/90 and this record is true to the best of my knowledge and belief. Kansas

Water Well Contractor's License No. 35 This Water Well Record was completed on (mo/day/year) 5/31/90

under the business name of Winter Well Drill by (signature) Charles Winter