

1 LOCATION OF WATER WELL:

Fraction

SE $\frac{1}{4}$ SW $\frac{1}{4}$

Section Number

12

Township Number

T 27 S

Range Number

R 3 EW

County: Butler

Distance and direction from nearest town or city street address of well if located within city?

4 West 3 N of Augusta

2 WATER WELL OWNER:

Lynn Maurer

67204

RR#, St. Address, Box #

Box 118 G


Board of Agriculture, Division of Water Resources

City, State, ZIP Code

Augusta

Application Number:

3 LOCATE WELL'S LOCATION WITH AN "X" IN SECTION BOX:

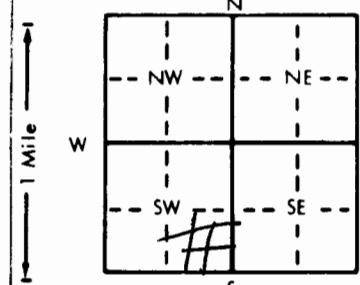

4 DEPTH OF COMPLETED WELL: 125 ft. ELEVATION:

Depth(s) Groundwater Encountered 100 ft. 2 ft. 3 ft.

WELL'S STATIC WATER LEVEL 40 ft. below land surface measured on mo/day/yr

Pump test data: Well water was ft. after hours pumping gpm

Est. Yield 70 gpm Well water was ft. after hours pumping gpm

Bore Hole Diameter 8 in. to ft., and in. to ft.

WELL WATER TO BE USED AS: 5 Public water supply 8 Air conditioning 11 Injection well

① Domestic 3 Feedlot 6 Oil field water supply 9 Dewatering 12 Other (Specify below)

2 Irrigation 4 Industrial 7 Lawn and garden only 10 Monitoring well

Was a chemical/bacteriological sample submitted to Department? Yes No If yes, mo/day/yr sample was submitted

Water Well Disinfected? Yes X No

5 TYPE OF BLANK CASING USED:

1 Steel 3 RMP (SR)
2 PVC 4 ABS

5 Wrought iron

8 Concrete tile

CASING JOINTS: Glued Clamped

6 Asbestos-Cement

9 Other (specify below)

Welded

7 Fiberglass

Threaded

Blank casing diameter 5 in. to 10 ft., Dia

lbs./ft. Wall thickness or gauge No. 214

Casing height above land surface 18 in., weight

TYPE OF SCREEN OR PERFORATION MATERIAL:

1 Steel 3 Stainless steel
2 Brass 4 Galvanized steel

5 Fiberglass

8 RMP (SR)

10 Asbestos-cement

6 Concrete tile

9 ABS

11 Other (specify)

5 Gauzed wrapped

10

12 None used (open hole)

6 Wire wrapped

11

Saw cut

13 None (open hole)

7 Torch cut

12

Drilled holes

14 Abandoned water well

SCREEN OR PERFORATION OPENINGS ARE: From ft. to ft., From ft. to ft., From ft. to ft.

From ft. to ft., From ft. to ft., From ft. to ft.

SCREEN-PERFORATED INTERVALS: From ft. to ft., From ft. to ft., From ft. to ft.

From ft. to ft., From ft. to ft., From ft. to ft.

GRAVEL PACK INTERVALS: From ft. to ft., From ft. to ft., From ft. to ft.

From ft. to ft., From ft. to ft., From ft. to ft.

6 GROUT MATERIAL: 1 Neat cement 2 Cement grout 3 Bentonite 4 Other

Grout Intervals: From ft. to ft., From ft. to ft., From ft. to ft.

What is the nearest source of possible contamination:

1 Septic tank 4 Lateral lines
2 Sewer lines 5 Cess pool
3 Watertight sewer lines 6 Seepage pit

7 Pit privy

8 Sewage lagoon

9 Feedyard

10 Livestock pens

11 Fuel storage

12 Fertilizer storage

13 Insecticide storage

14 Abandoned water well

15 Oil well/Gas well

16 Other (specify below)

How many feet? 250

Direction from well? 5- East

FROM TO LITHOLOGIC LOG FROM TO PLUGGING INTERVALS

0 3 Soil

13 125 Clay

13 125 Lime & Shale

7 CONTRACTOR'S OR LANDOWNER'S CERTIFICATION: This water well was ① constructed, (2) reconstructed, or (3) plugged under my jurisdiction and was completed on (mo/day/year) 11/18/90 and this record is true to the best of my knowledge and belief. Kansas

Water Well Contractor's License No. 257 This Water Well Record was completed on (mo/day/year) 11/18/90 by (signature) Charles Winter

INSTRUCTIONS: Use typewriter or ball point pen. PLEASE PRESS FIRMLY and PRINT clearly. Please fill in blanks, underline or circle the correct answers. Send top three copies to Kansas Department of Health and Environment, Bureau of Water, Topeka, Kansas 66620-7320. Telephone: 913-296-5545. Send one to WATER WELL OWNER and retain one for your records.